


GREEN BAY, WIS.

FORT HOWARD MILITARY RESERVE

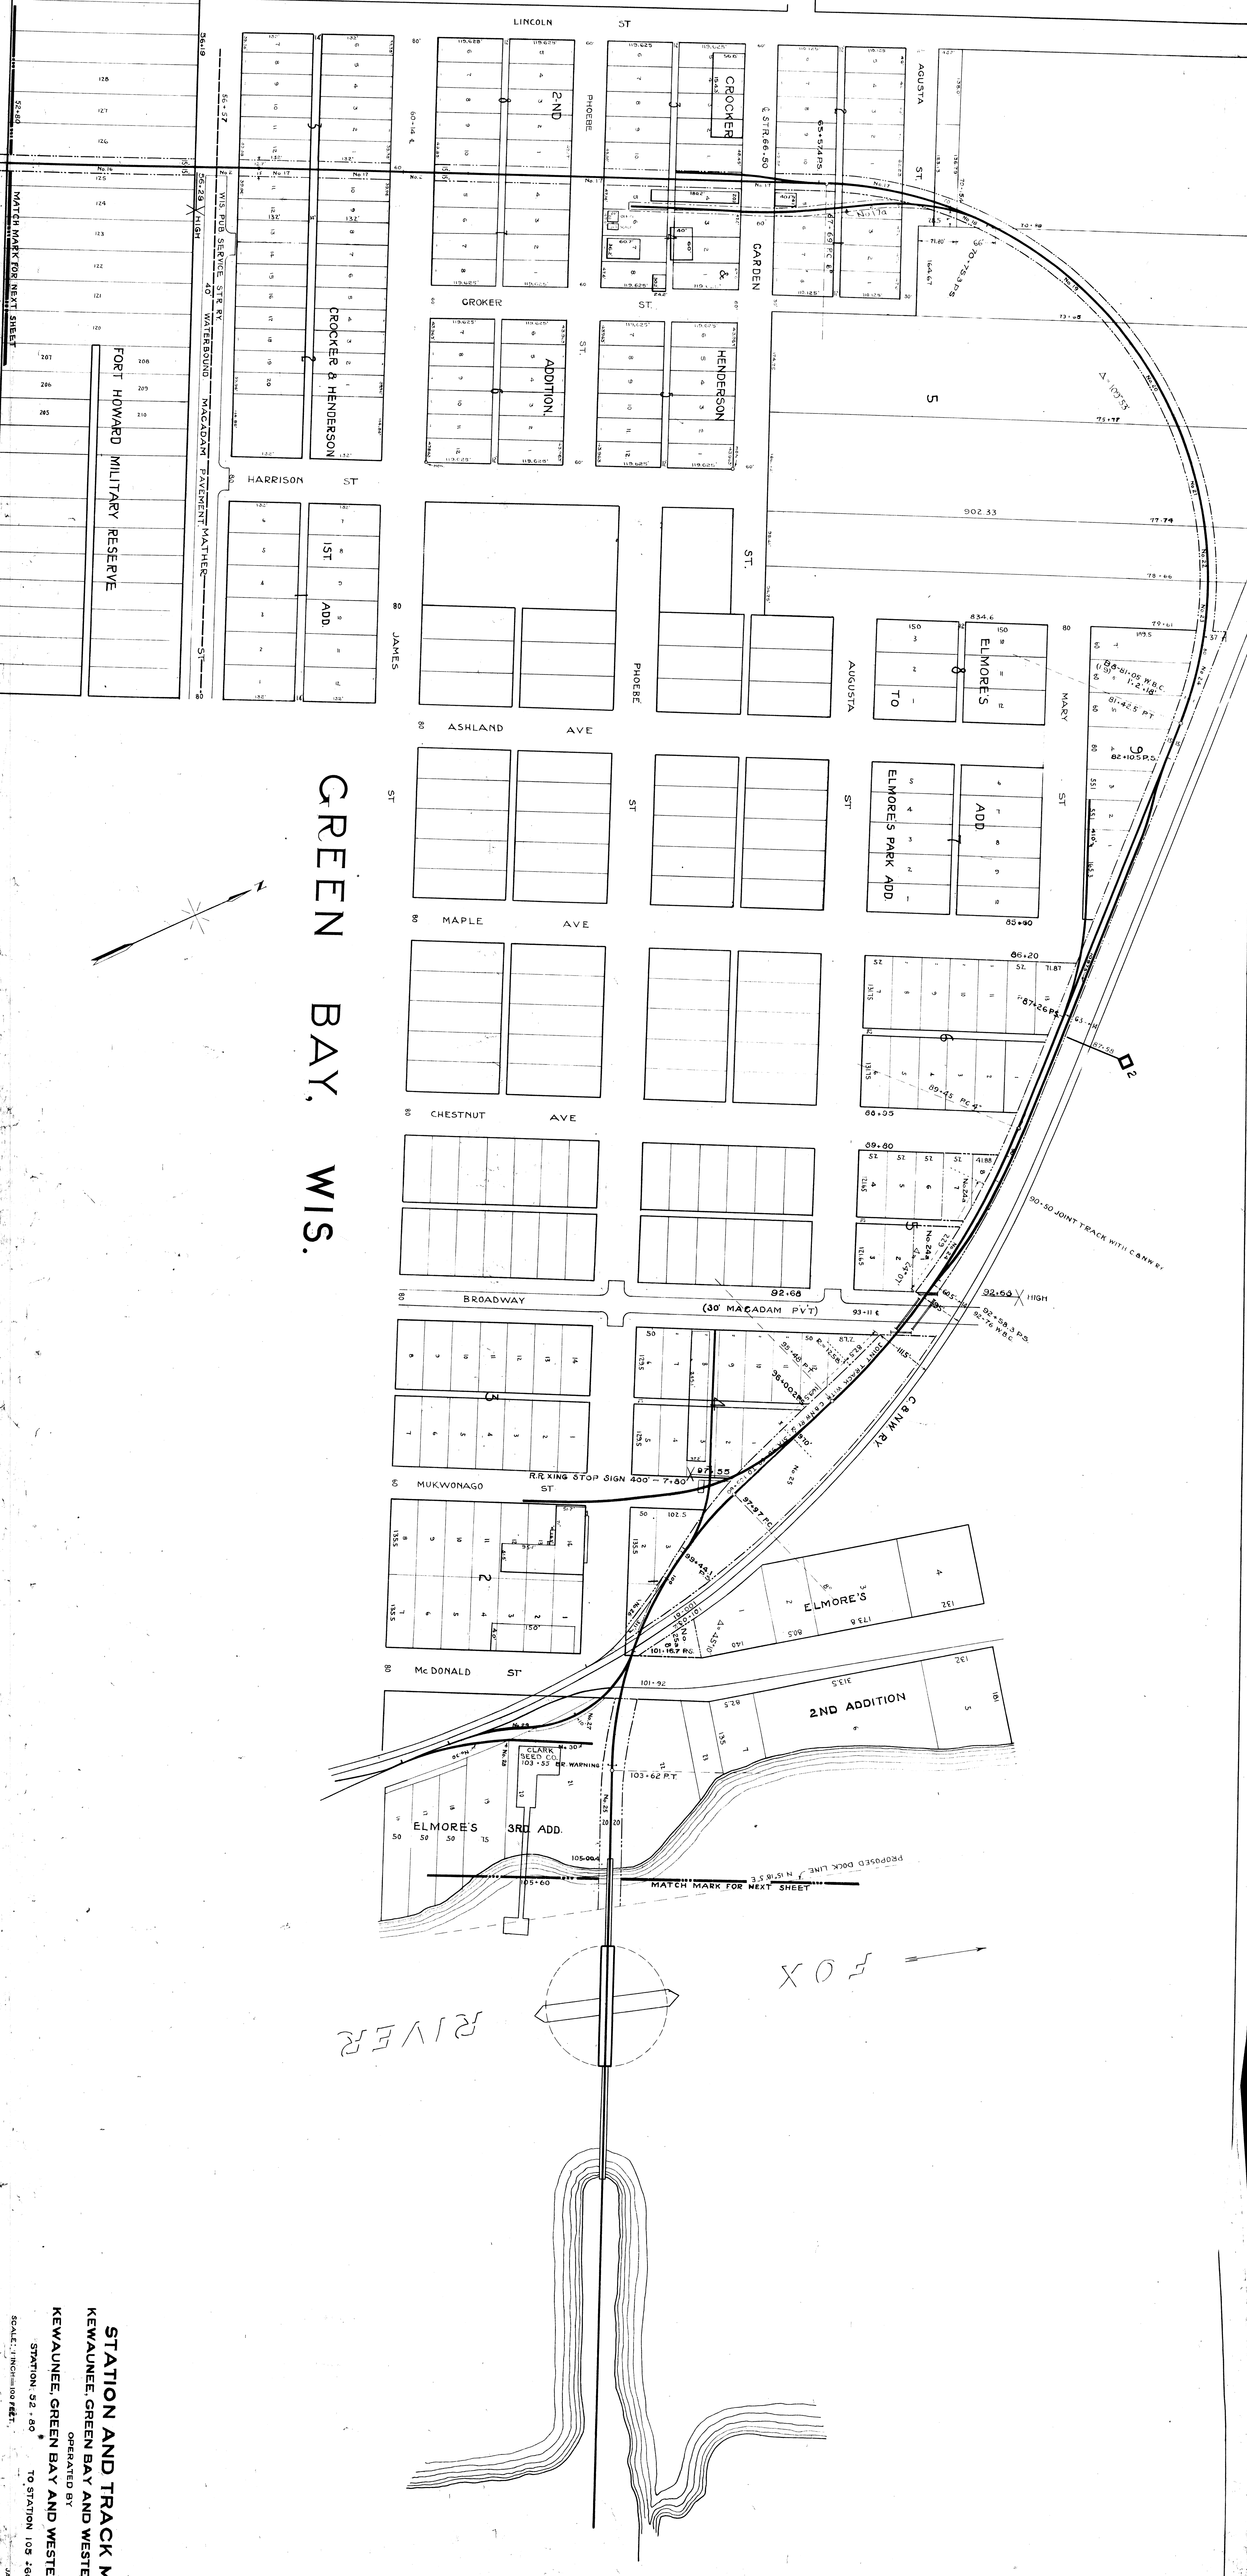

STATION AND TRACK MAP
KEWAUNEE, GREEN BAY AND WESTERN R.R.
OPERATED BY
KEWAUNEE, GREEN BAY AND WESTERN R.R.
SCALE: 1"=100 FEET
JAN. 1, 1922
OFFICE OF CHIEF ENGINEER
GREEN BAY, WIS.

