


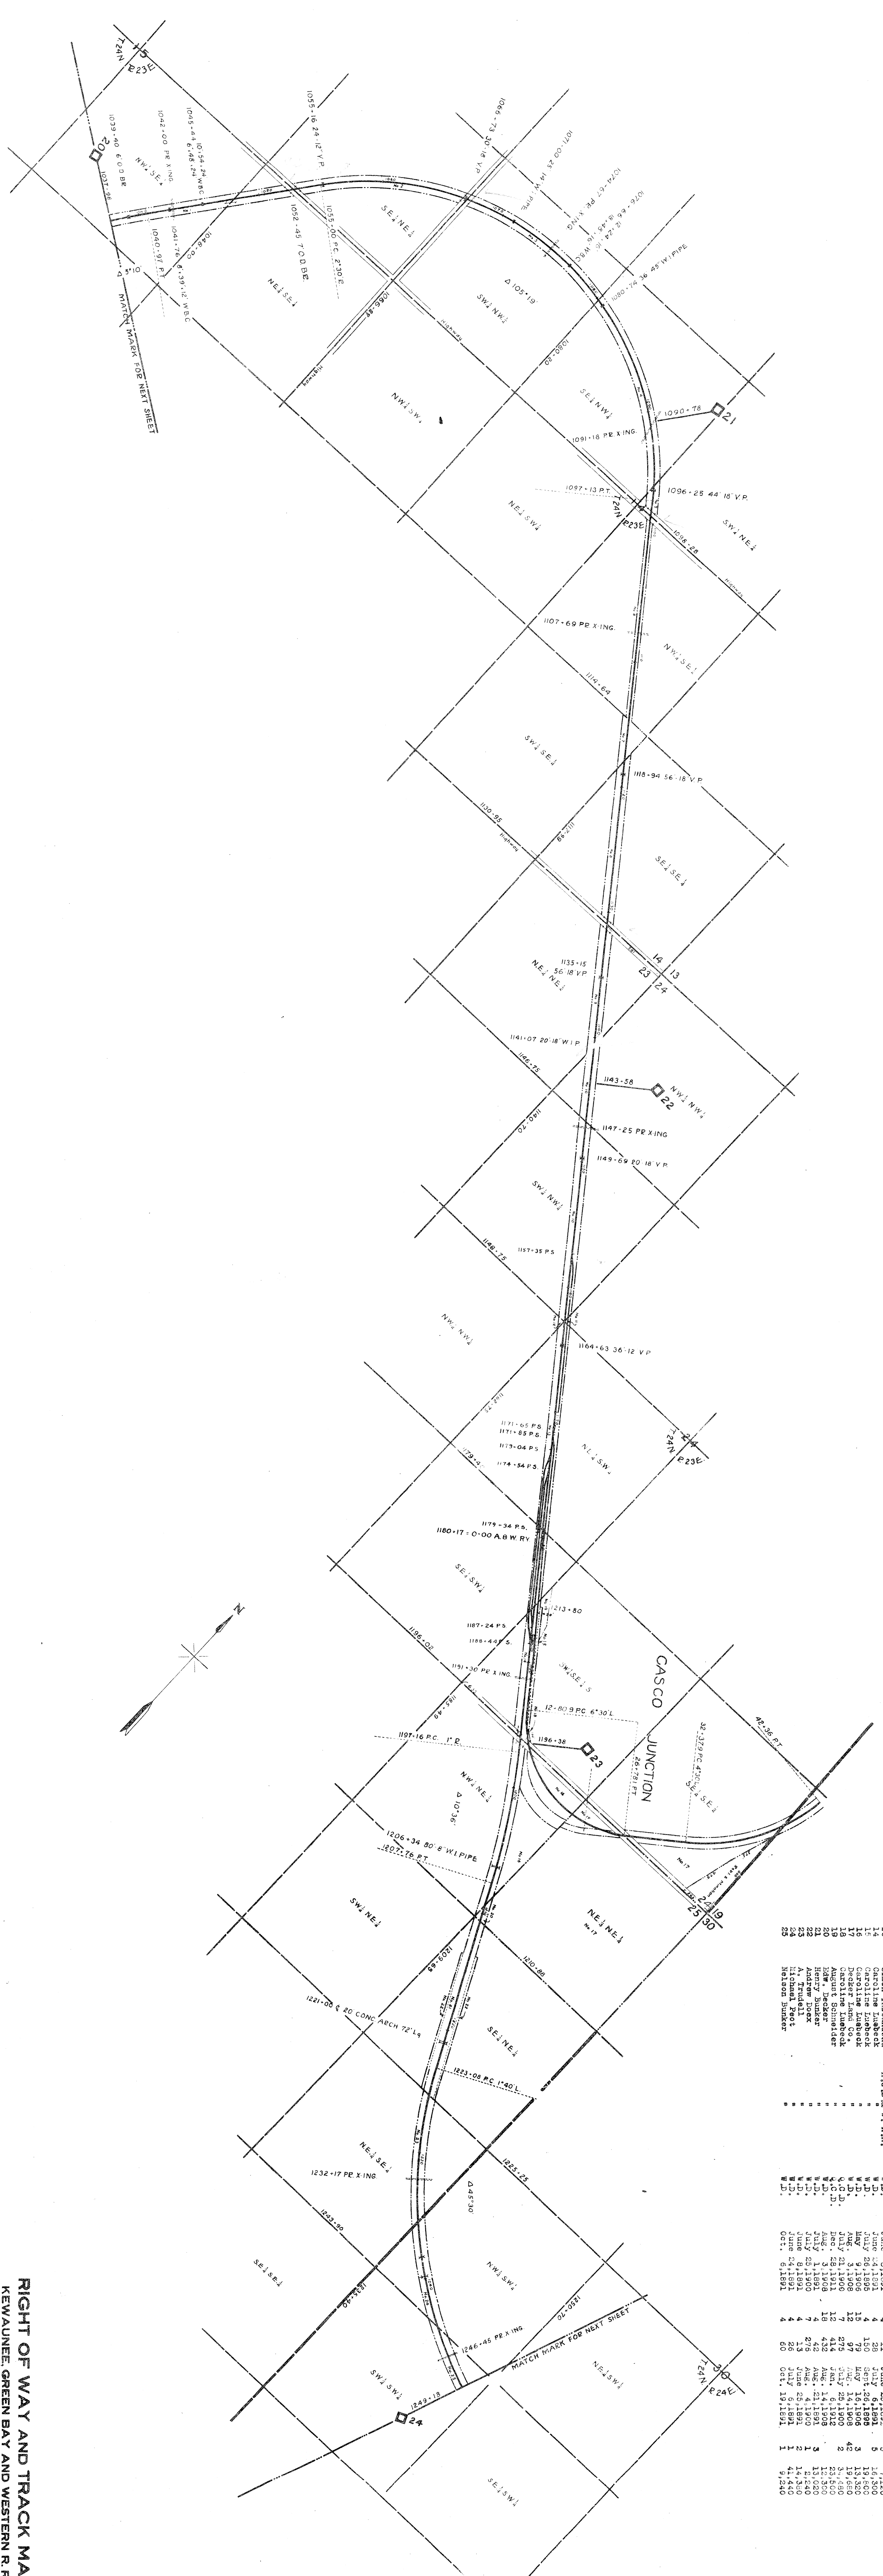

NUMBER	GRANTEE	GRANTOR	INSTRUMENT	DATE	RECORD	AREA	REMARKS
1	Chas. Vorholt	K.G.B. & W.R.R.	W.D.	June 24, 1891	4	13.50	
2	Peter Arndt	"	W.D.	Sept. 12, 1891	4	1.680	
3	Oscar Schneider	"	W.D.	June 24, 1891	4	42.480	
4	Chas. Rader	"	W.D.	June 24, 1891	4	19.150	
5	George Kautel	"	W.D.	July 27, 1891	4	36.240	
6	Peter Hoffman	"	W.D.	Sept. 12, 1891	4	1.680	
7	Amund Schuetz	"	W.D.	June 24, 1891	4	1.680	
8	Catherine Vandel	"	W.D.	June 24, 1891	4	1.680	
9	Thos. Druy	"	W.D.	Dec. 19, 1891	4	36.280	
10	John Hase	"	W.D.	Dec. 19, 1891	4	2.480	
11	Simon Tilsandeen	"	W.D.	June 24, 1891	4	7.180	
12	Caroline Innes	"	W.D.	June 24, 1891	4	16.500	
13	Caroline Innes	"	W.D.	June 24, 1891	4	16.500	
RIGHT OF WAY AND TRACK MAP
KEWAUNEE, GREEN BAY AND WESTERN R.R.
OPERATED BY
KEWAUNEE, GREEN BAY AND WESTERN R.R.
STATION 1037+98 TO STATION 1249+18
SCALE: 1 INCH = 400 FEET
OFFICE OF CHIEF ENGINEER
GREEN BAY, WIS.
JUNE 20, 1898

