


No.	Location	Contract	Instrument	Date	Record

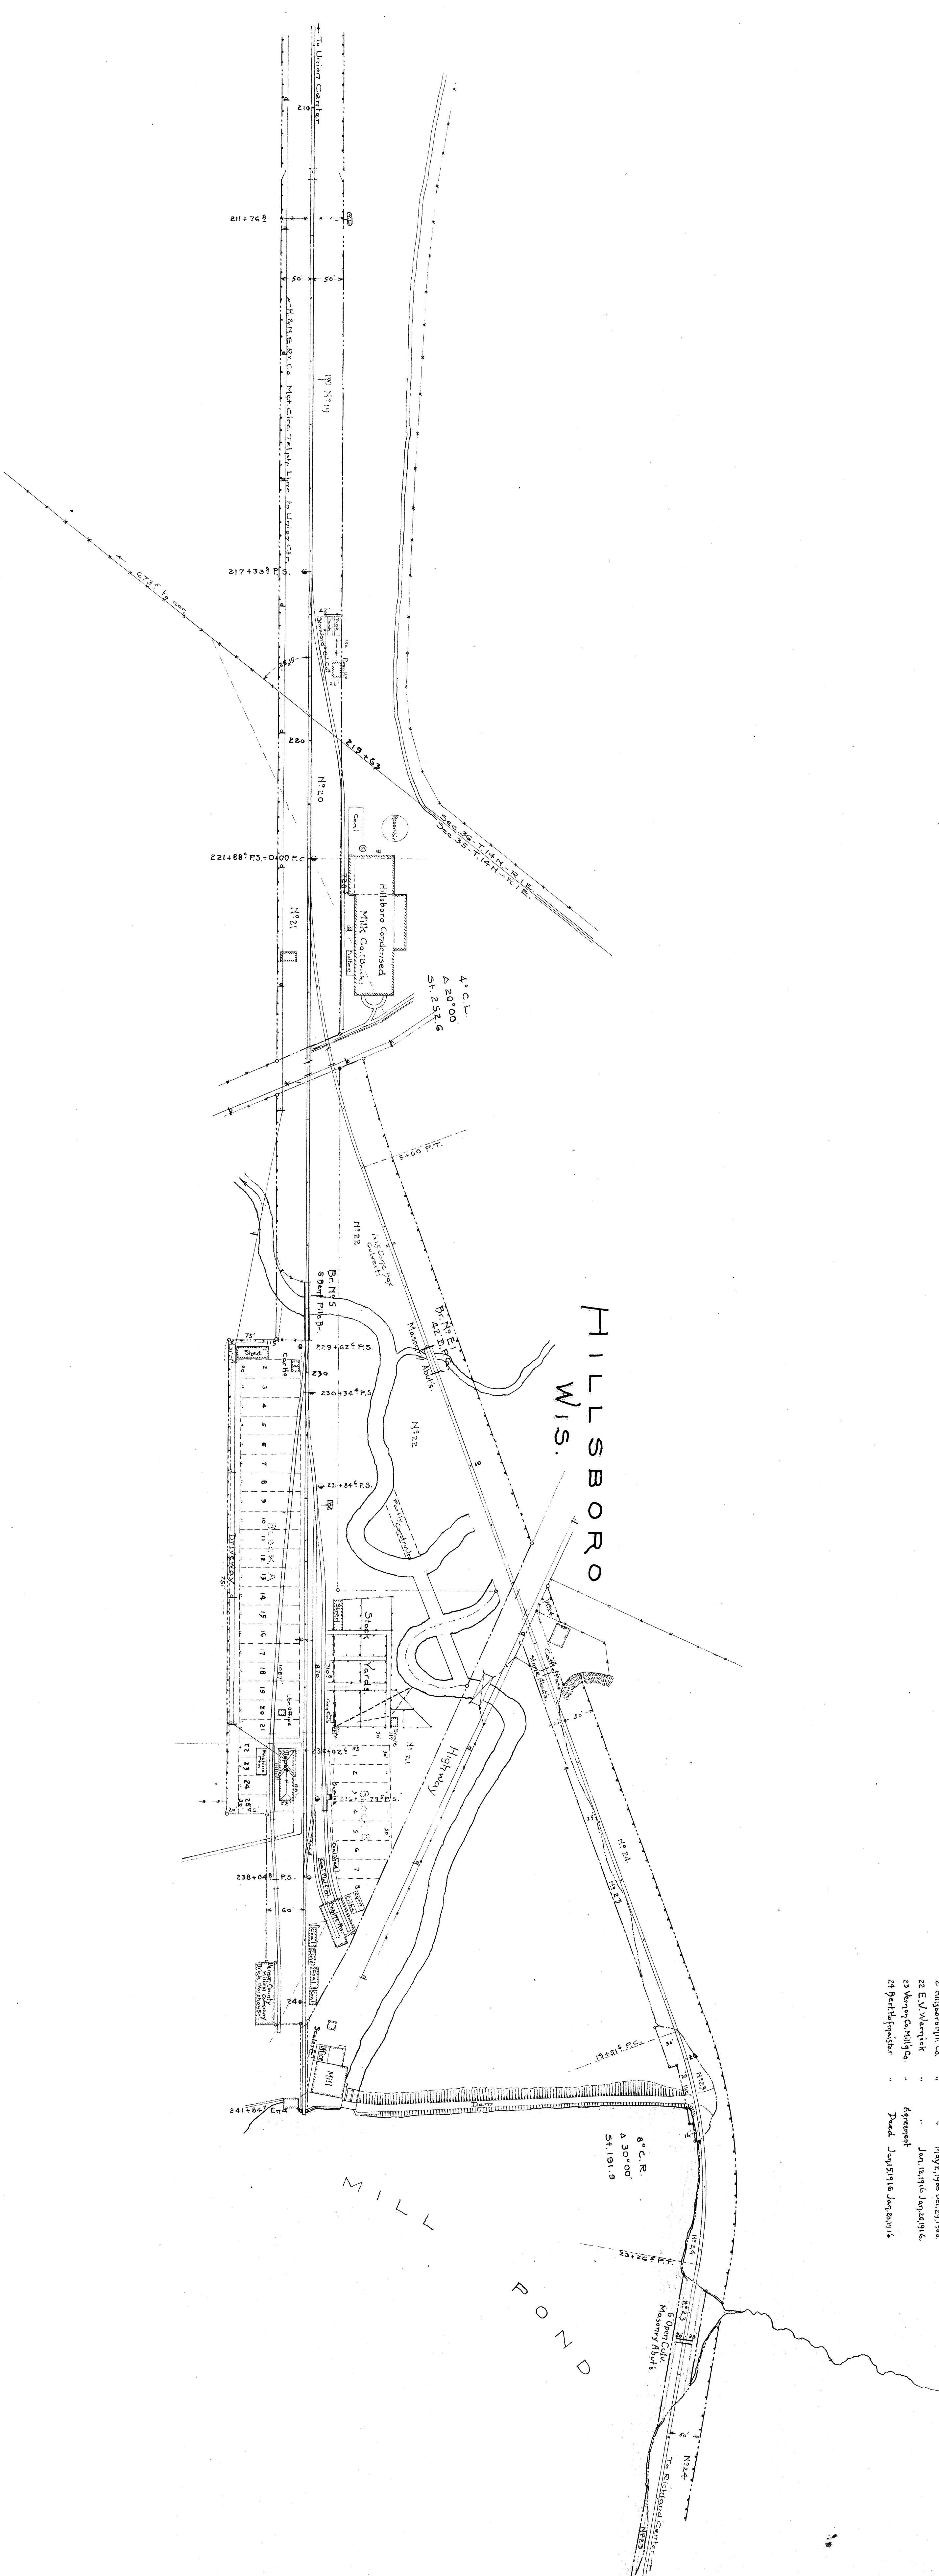

Sheet 15012 of Hillsboro, North Eastern Railway from
Survey Station 210+00 to Station 241+847, also from
Station 210+00 to Station 281+00 of the survey.

E. J. Gault
Engineer

HILLSBORO, WIS.
STATION MAP
LANDS, TRACKS & STRUCTURES
HILLSBORO & NORTH EASTERN RY. CO.
OPERATED BY THE
MAIN LINE
STATION 210+00 TO STATION 241+847
SCALE 1"=100 FT. OCT. 26, 1916
OFFICE OF CHIEF ENGINEER
HILLSBORO, WIS.