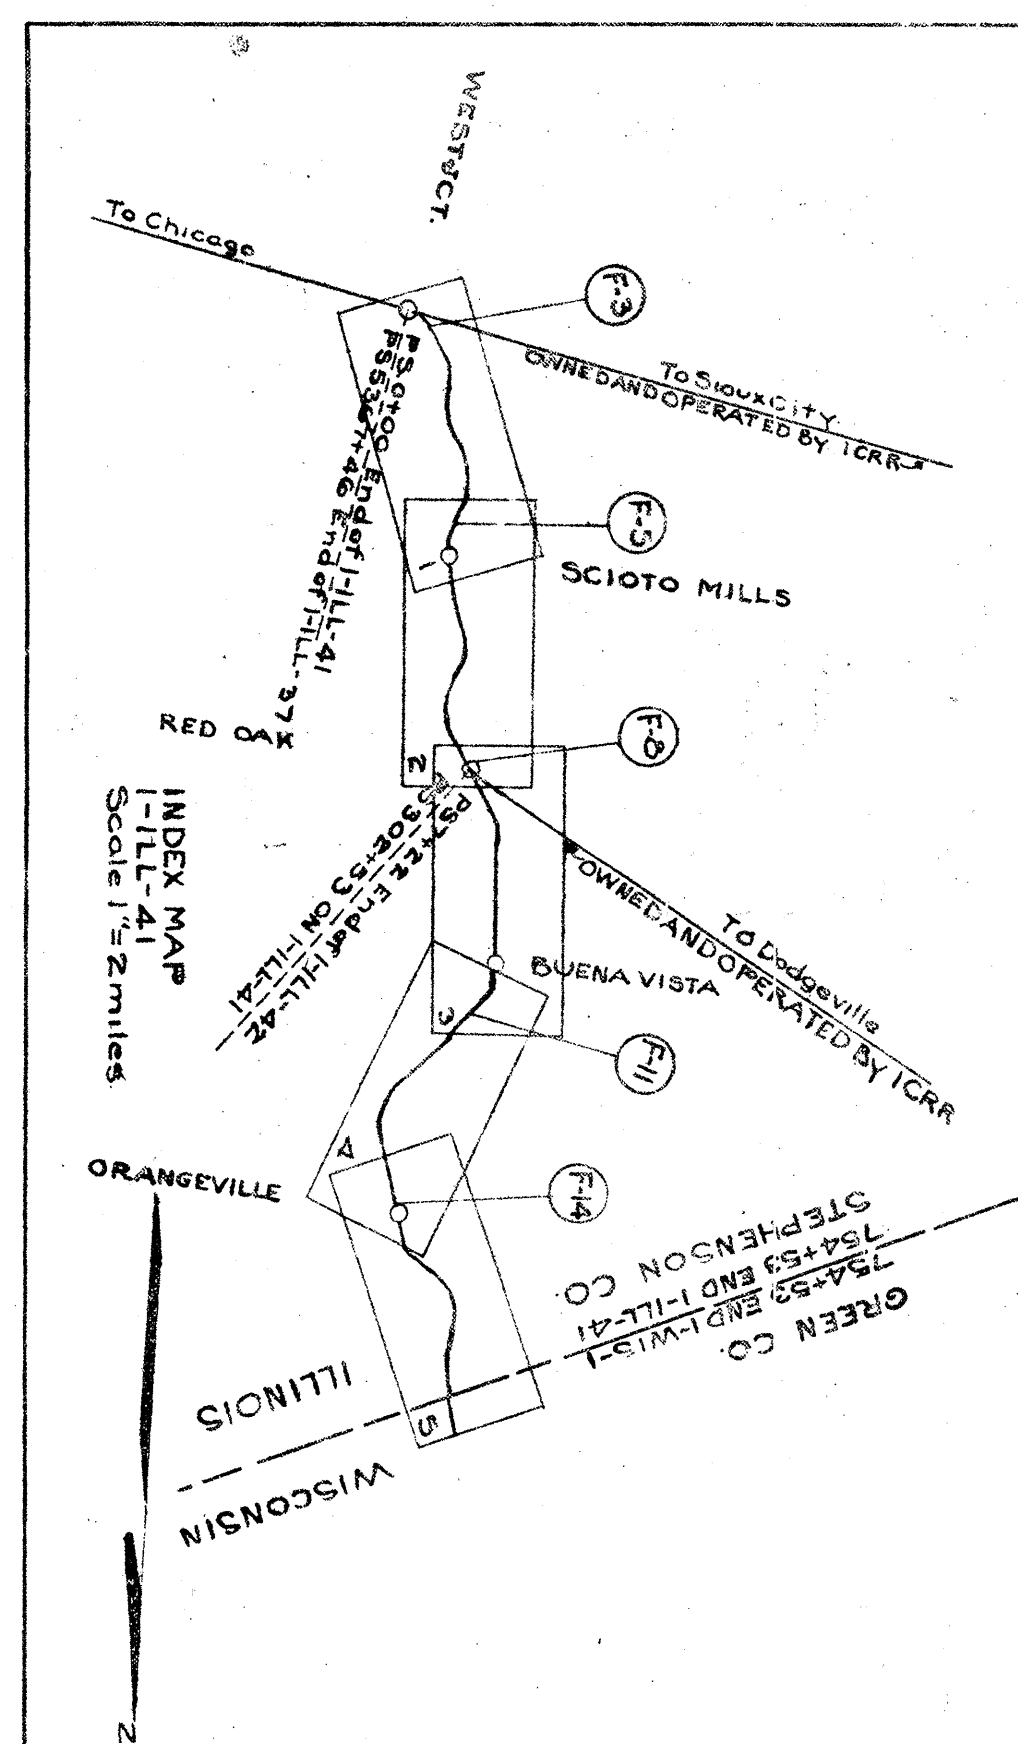
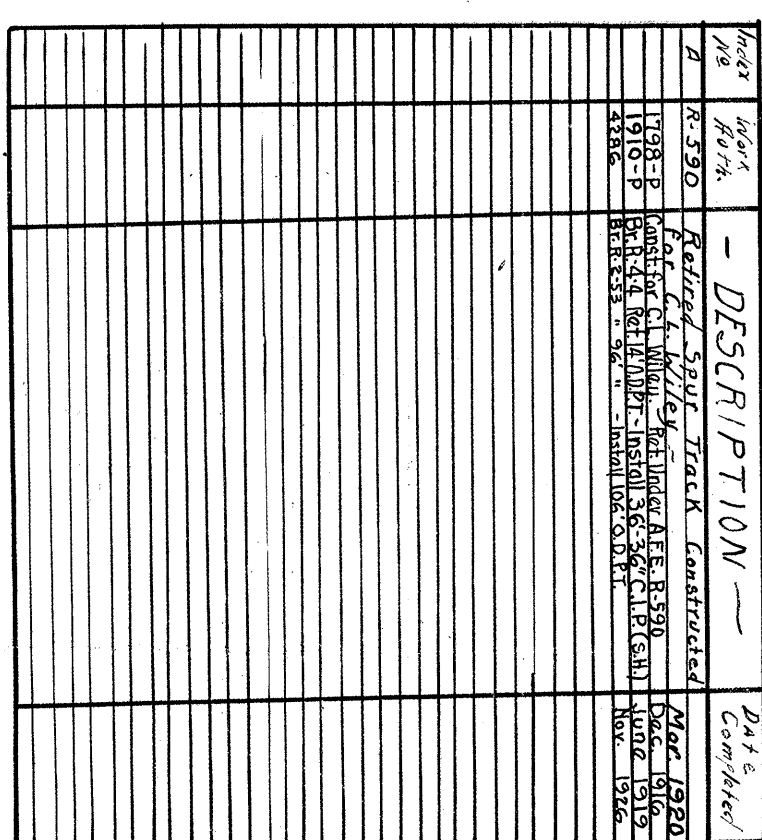


[illegible]

RIGHT-OF-WAY AND TRACK MAP
ILLINOIS CENTRAL RAILROAD
WEST JCT., ILL. TO ILL.-WIS. STATE

WEST JCT., ILL. TO ILL.-WIS. STATE LINE

ON O+OO TO STATION 137+3

SCALE-1 IN. = 300 FT.

JUNE 30, 1915

OFFICE OF CHIEF ENGINEER.


DRAWING NO. 25