SOLD TO
WIS. DEPT. OF TRANS.
DEC. 29-1980, X38000

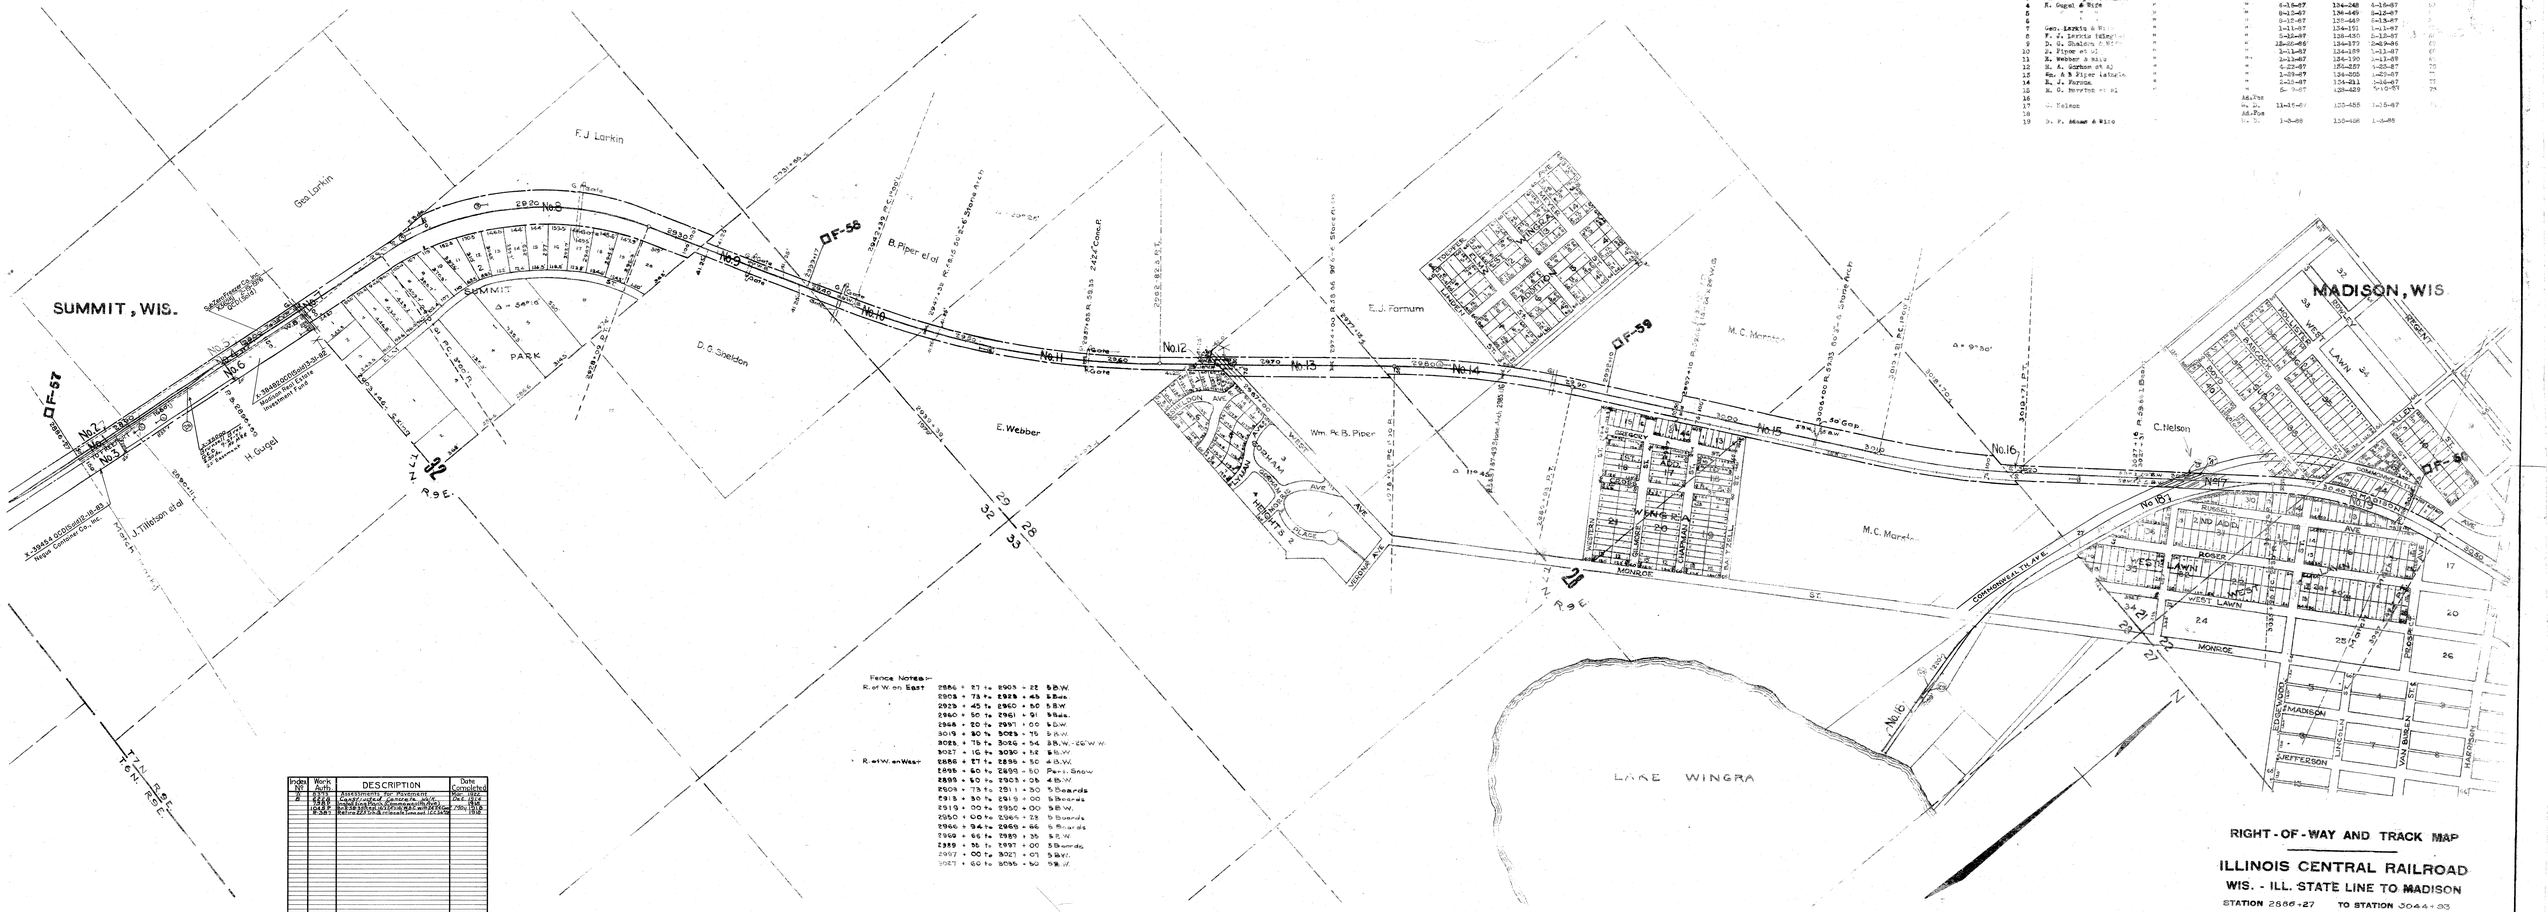

No.	Index No.	Work Auth.	DESCRIPTION	Date Completed

Fence Notes:-

R. of W. on East	2886 + 27	to 2903 + 22	5 B.W.
	2903 + 73	to 2928 + 45	5 Barb.
	2928 + 45	to 2960 + 50	5 B.W.
	2960 + 50	to 2961 + 91	5 Barb.
	2946 + 20	to 2997 + 00	5 B.W.
	3019 + 80	to 3028 + 75	5 B.W.
	3028 + 75	to 3026 + 54	5B.W.-26 W.W.
	3027 + 16	to 3030 + 52	5 B.W.
R. of W. on West	2886 + 27	to 2895 + 50	4 B.W.
	2895 + 50	to 2898 + 50	Perm. Snow
	2898 + 50	to 2903 + 06	4 B.W.
	2903 + 73	to 2911 + 30	5 Boards
	2911 + 30	to 2915 + 00	5 Boards
	2919 + 00	to 2950 + 00	5 B.W.
	2950 + 00	to 2966 + 23	5 Boards
	2966 + 94	to 2969 + 66	5 Boards
	2969 + 66	to 2989 + 35	5 B.W.
	2989 + 35	to 2997 + 00	5 Boards
	2997 + 00	to 3021 + 01	5 B.W.
	3021 + 80	to 3095 + 50	5 B.W.

No.	Owner	Location	Agent	Date	Deed Book	Deed Page
-	(W. Tillotson	M.& P. 55	W. D.	4-23-87	138-486	481
1	Wm. Tillotson et al	"	"	5- 4-87	138-486	83-41
	(J. Tillotson et al	"	"	4-23-87	138-534	84-111
	(J. Tillotson, et al	"	"	4-23-87	138-416	84-111
2	Wm. & F Piper Estate	"	"	8-17-87	138-480	60
3	Wm. & F Piper (Estate)	"	"	8-17-87	138-480	70
4	E. Gugel & Wife	"	"	8-13-87	134-248	67
5	" "	"	"	8-13-87	134-249	68
6	" "	"	"	8-13-87	138-489	69
7	Geo. Larkin & Wife	"	"	1-11-87	134-191	1-11-87
8	F. J. Larkin Estate	"	"	1-12-87	138-430	1-12-87
9	D. C. Sheldon & Wife	"	"	12-26-86	134-177	2-19-86
10	B. Piper et al	"	"	1-13-87	134-189	1-13-87
11	E. Webber & Wife	"	"	1-13-87	136-190	1-13-87
12	E. A. Gorham et al	"	"	4-23-87	150-257	1-23-87
13	Wm. & B Piper Estate	"	"	1-19-87	134-205	1-20-87
14	E. J. Farnum	"	"	2-13-87	134-211	1-16-87
12	E. C. Havens et al	"	"	1-5-87	138-429	1-15-87
16			Admr.			
17	" Nelson		Ex. &c.	11-14-87	133-485	1-15-87
18			Admr.			
19	D. F. Mead & Wife		D. D.	1-3-88	130-466	1-3-88

Sheet No. of 16 of valuation section 1 Wis.1 Wisconsin-Illinois State Line to Madison of the Illinois Central Railroad Company. From survey station 754+53 to survey station 3037+45.

Valuation Engineer

RIGHT-OF-WAY AND TRACK MAP

ILLINOIS CENTRAL RAILROAD

WIS. - ILL. STATE LINE TO MADISON

STATION 2886+27 TO STATION 3044+93

M. P. F-57 TO M. P. F-66

SCALE- 1 IN. = 200 FT. - JUNE 30, 1910, REV. DEC. 31, 1927

Land - " - " 1938

OFFICE OF CHIEF ENGINEER.

CHICAGO, ILL.

1-Wis.1

15