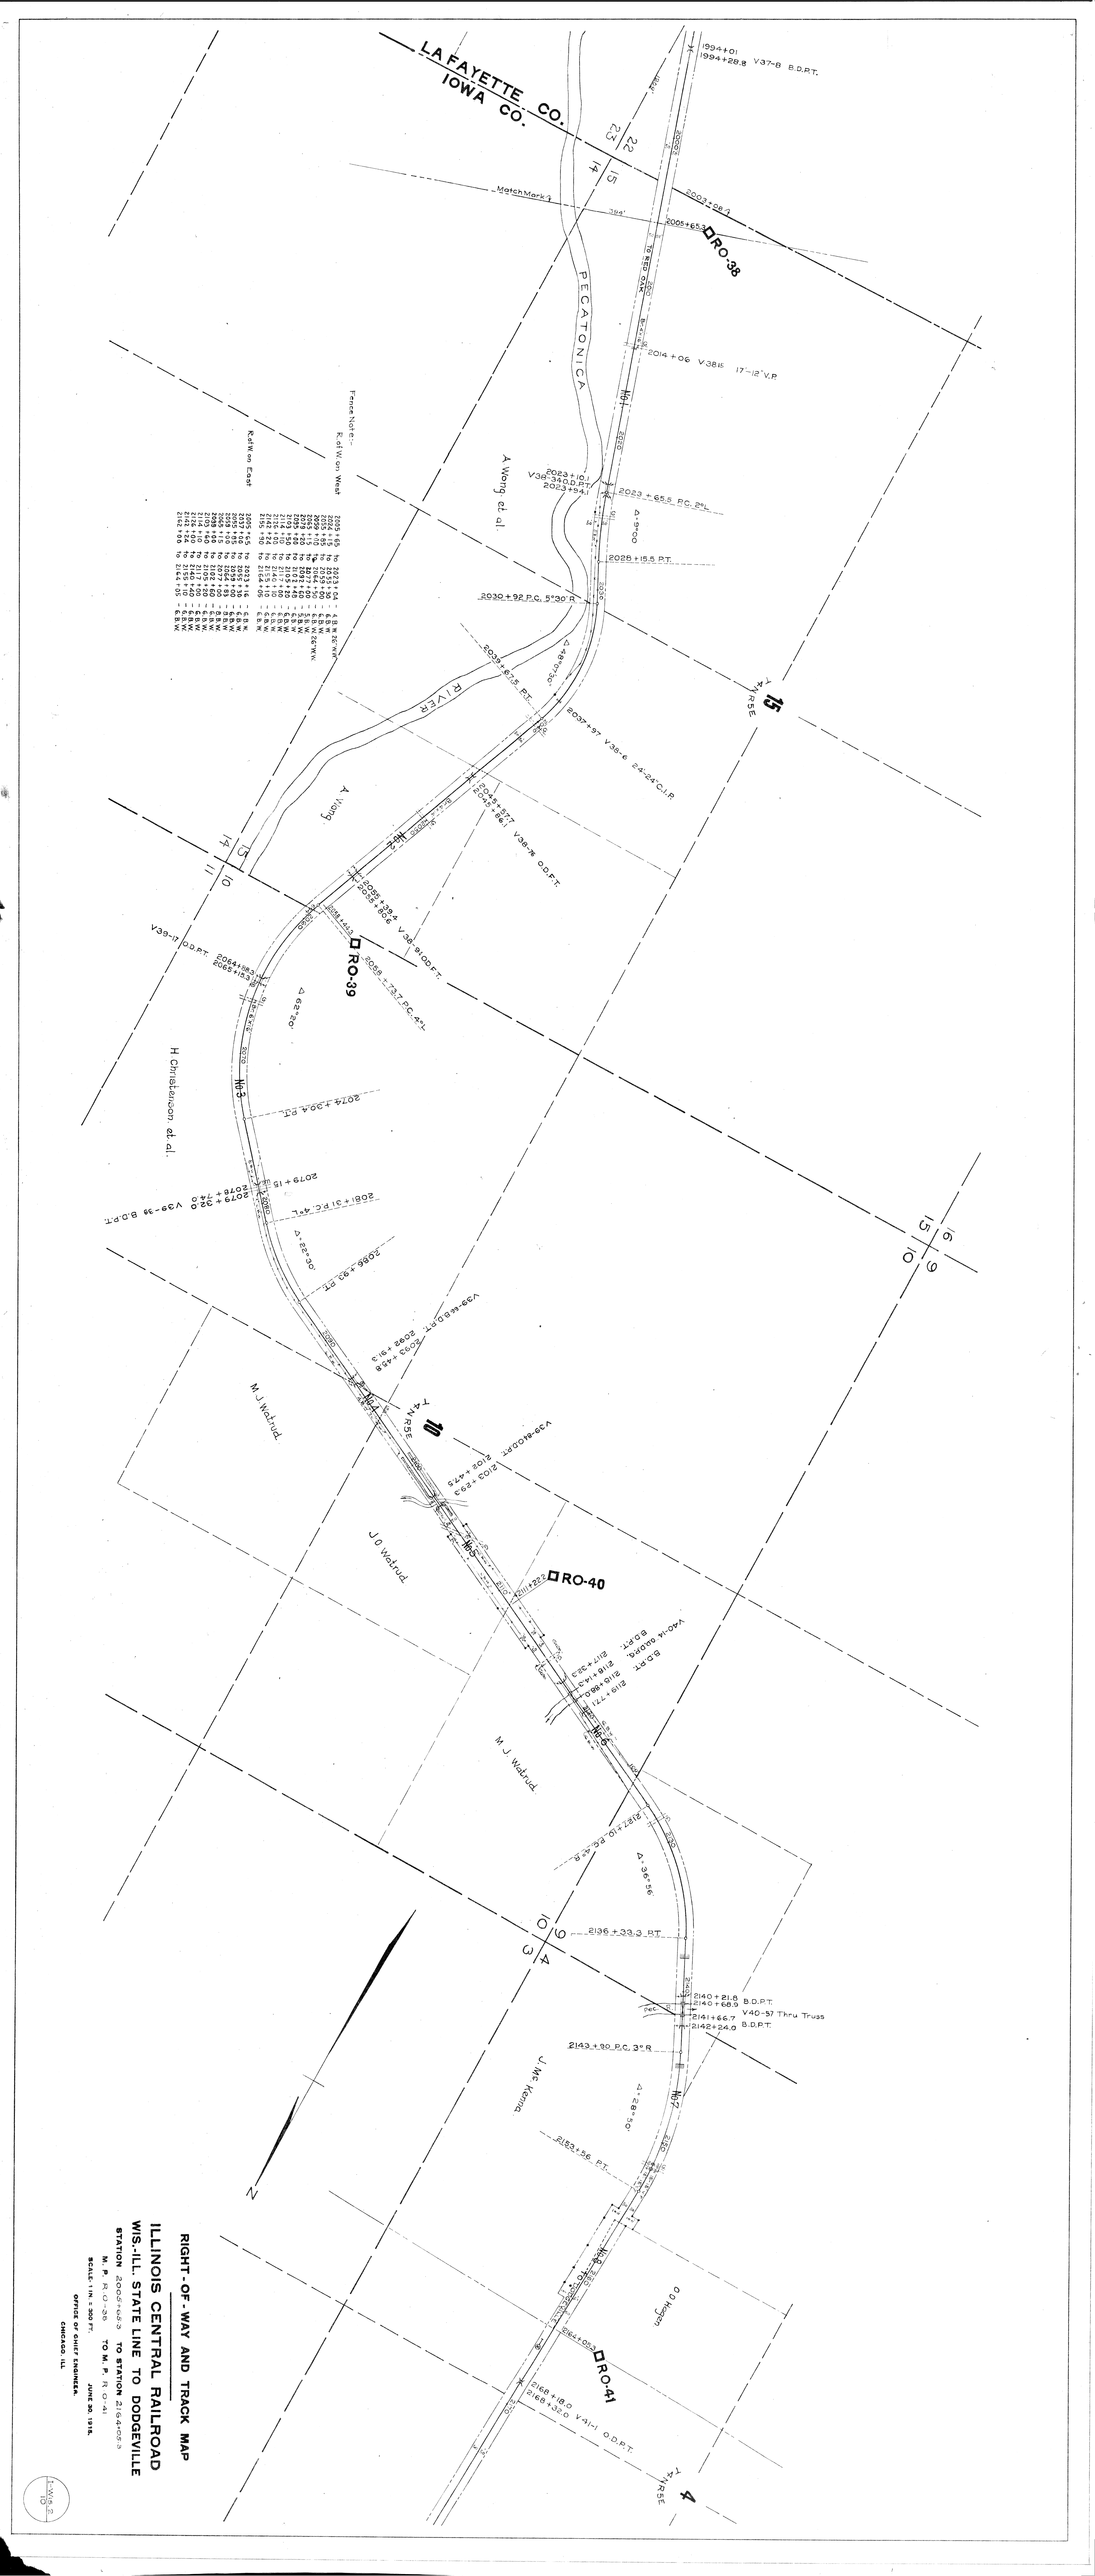

RIGHT-OF-WAY AND TRACK MAP

ILLINOIS CENTRAL RAILROAD

WIS.-ILL. STATE LINE TO DODGEVILLE

STATION 2005+65.3 TO STATION 2164+05.3

M. P. R. O.-38 TO M. P. R. O.-41

SCALE: 1 IN. = 200 FT. JUNE 30, 1914.

OFFICE OF CHIEF ENGINEER,
CHICAGO, ILL.

Sheet 10