


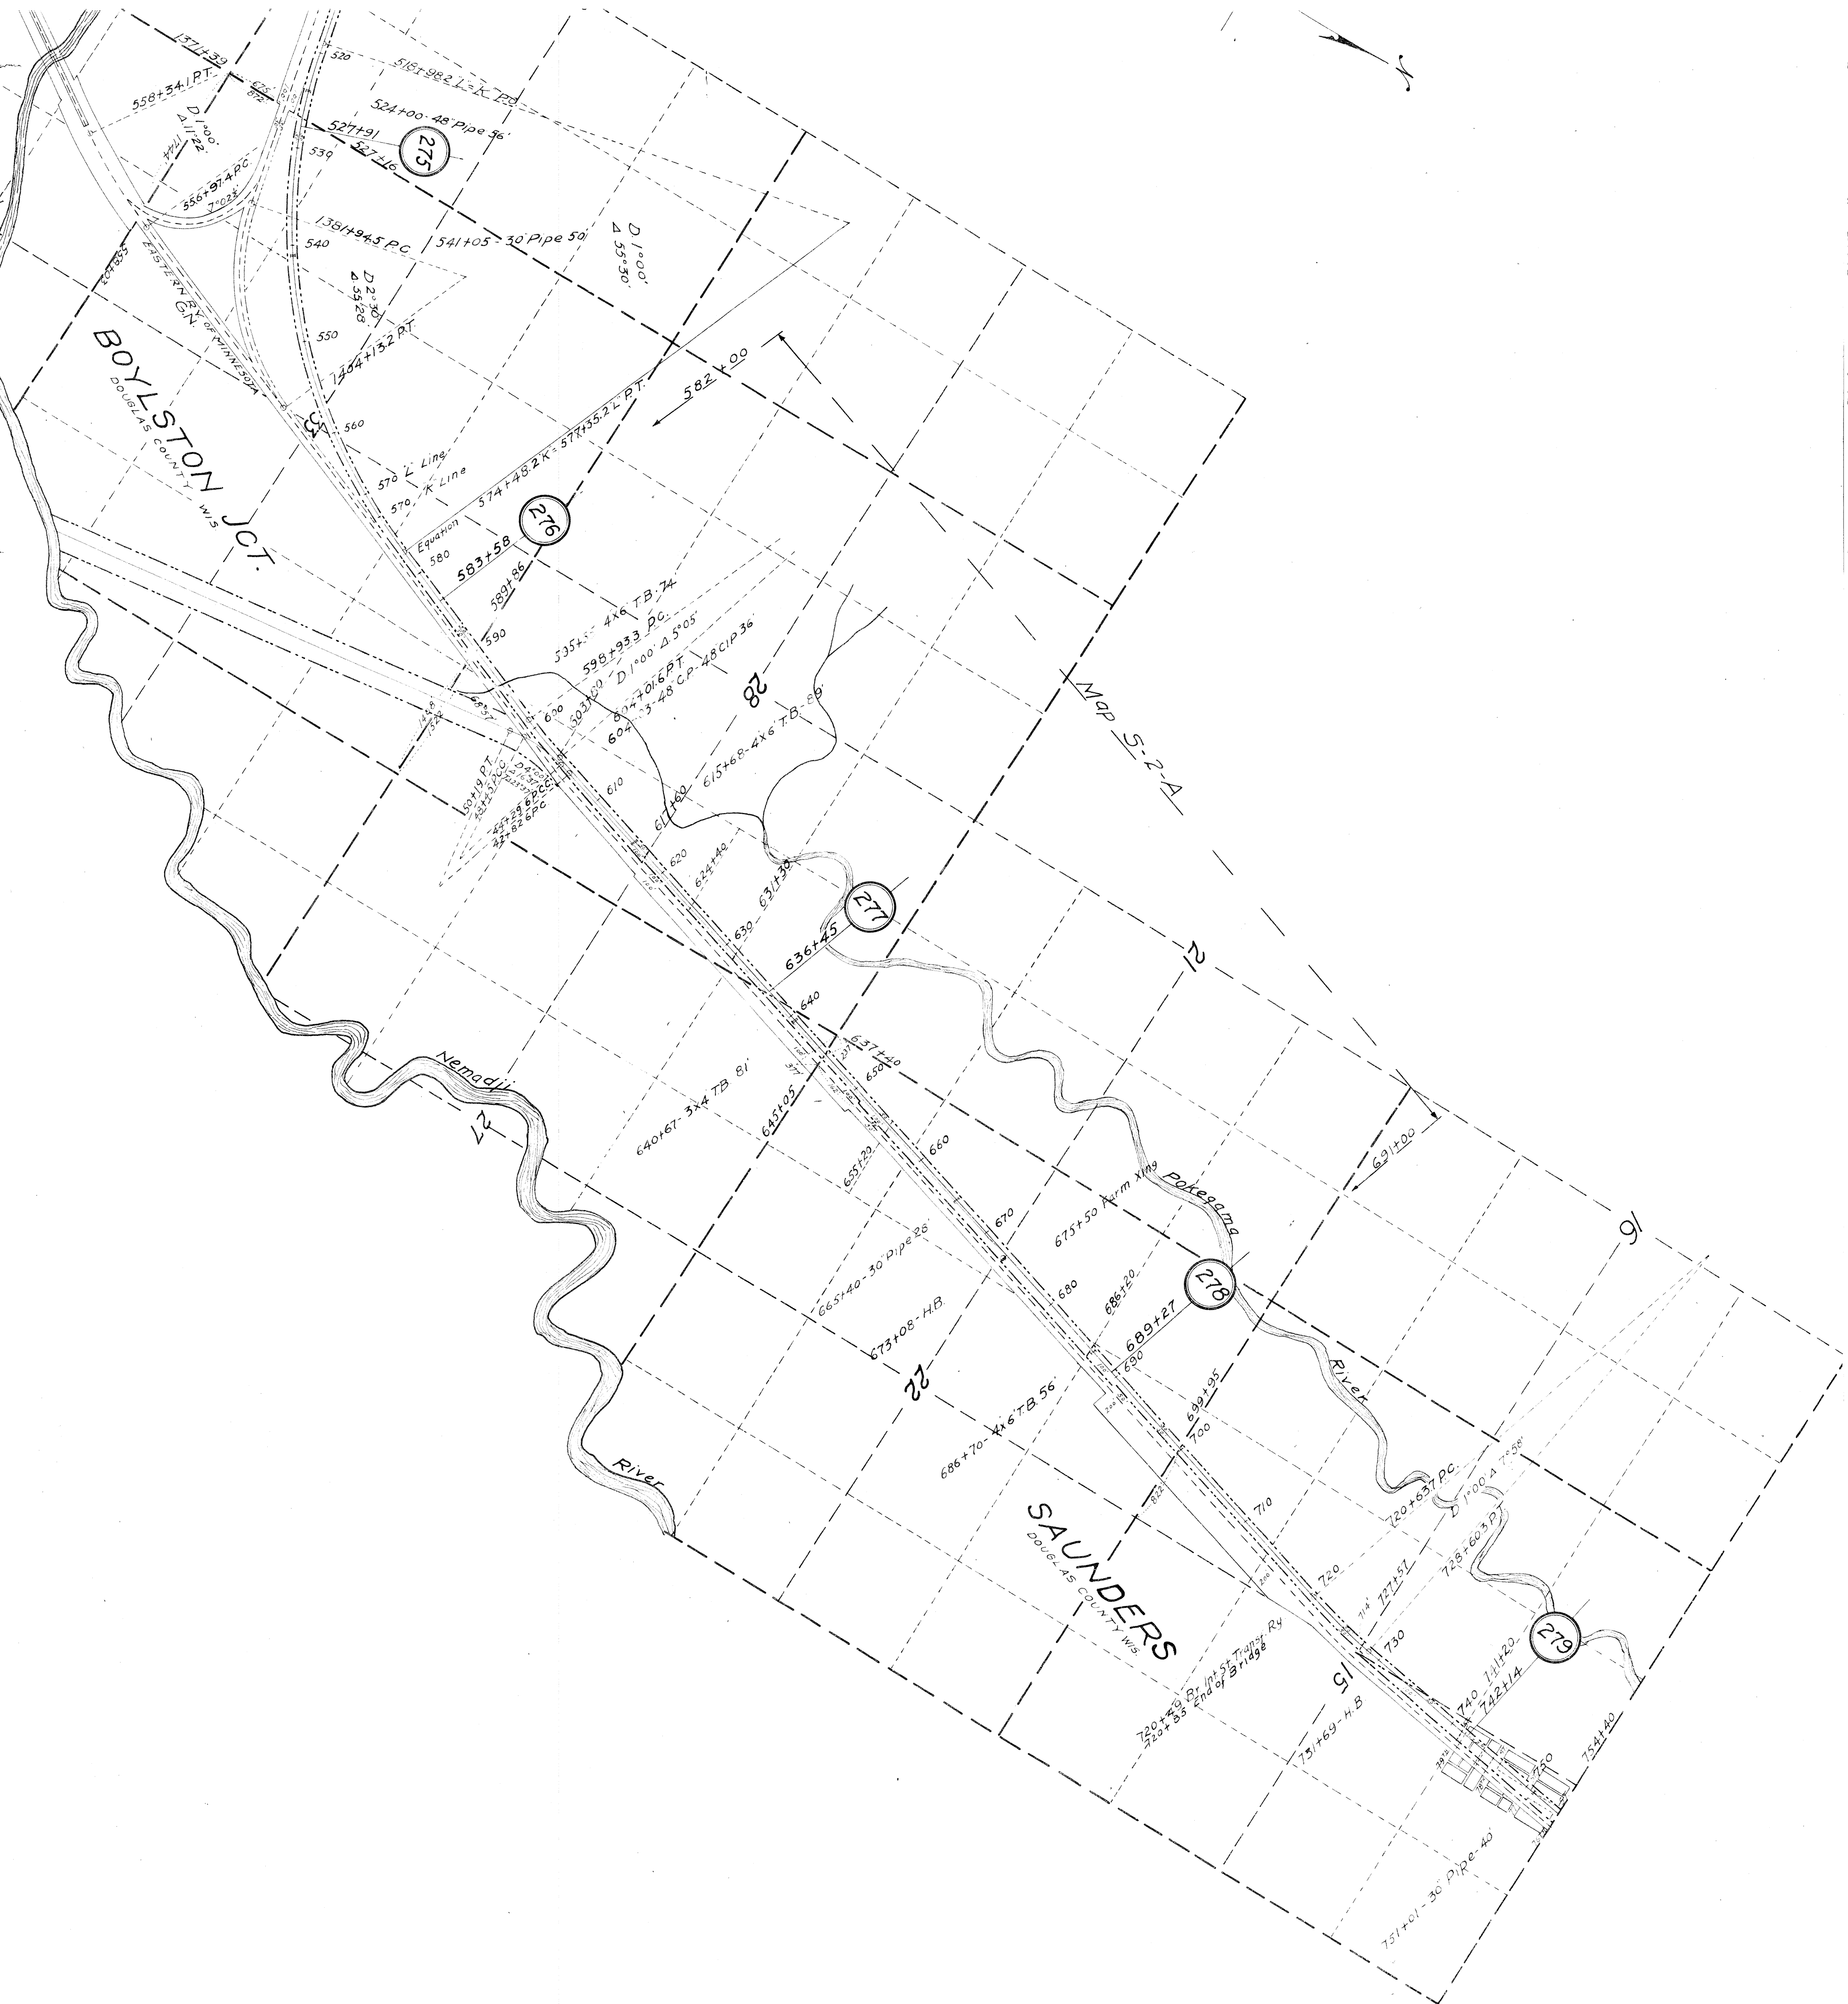

RIGHT-OF-WAY AND TRACK MAP
MINNEAPOLIS, ST. PAUL & SAULT STE. MARIE RY.
Operated by the
MINNEAPOLIS, ST. PAUL & SAULT STE. MARIE RY.
BROOKEN TO DULUTH.
DOUGLAS COUNTY WISCONSIN.
Station 10+82 to Station 754+40
Mile Post 267+1042 to Mile Post 279+1226
Scale - 1 in. = 800' June 30, 1916
Office of Chief Engineer
Minneapolis, Minn.

PLAN 1983-
FILE D-24-B-3