


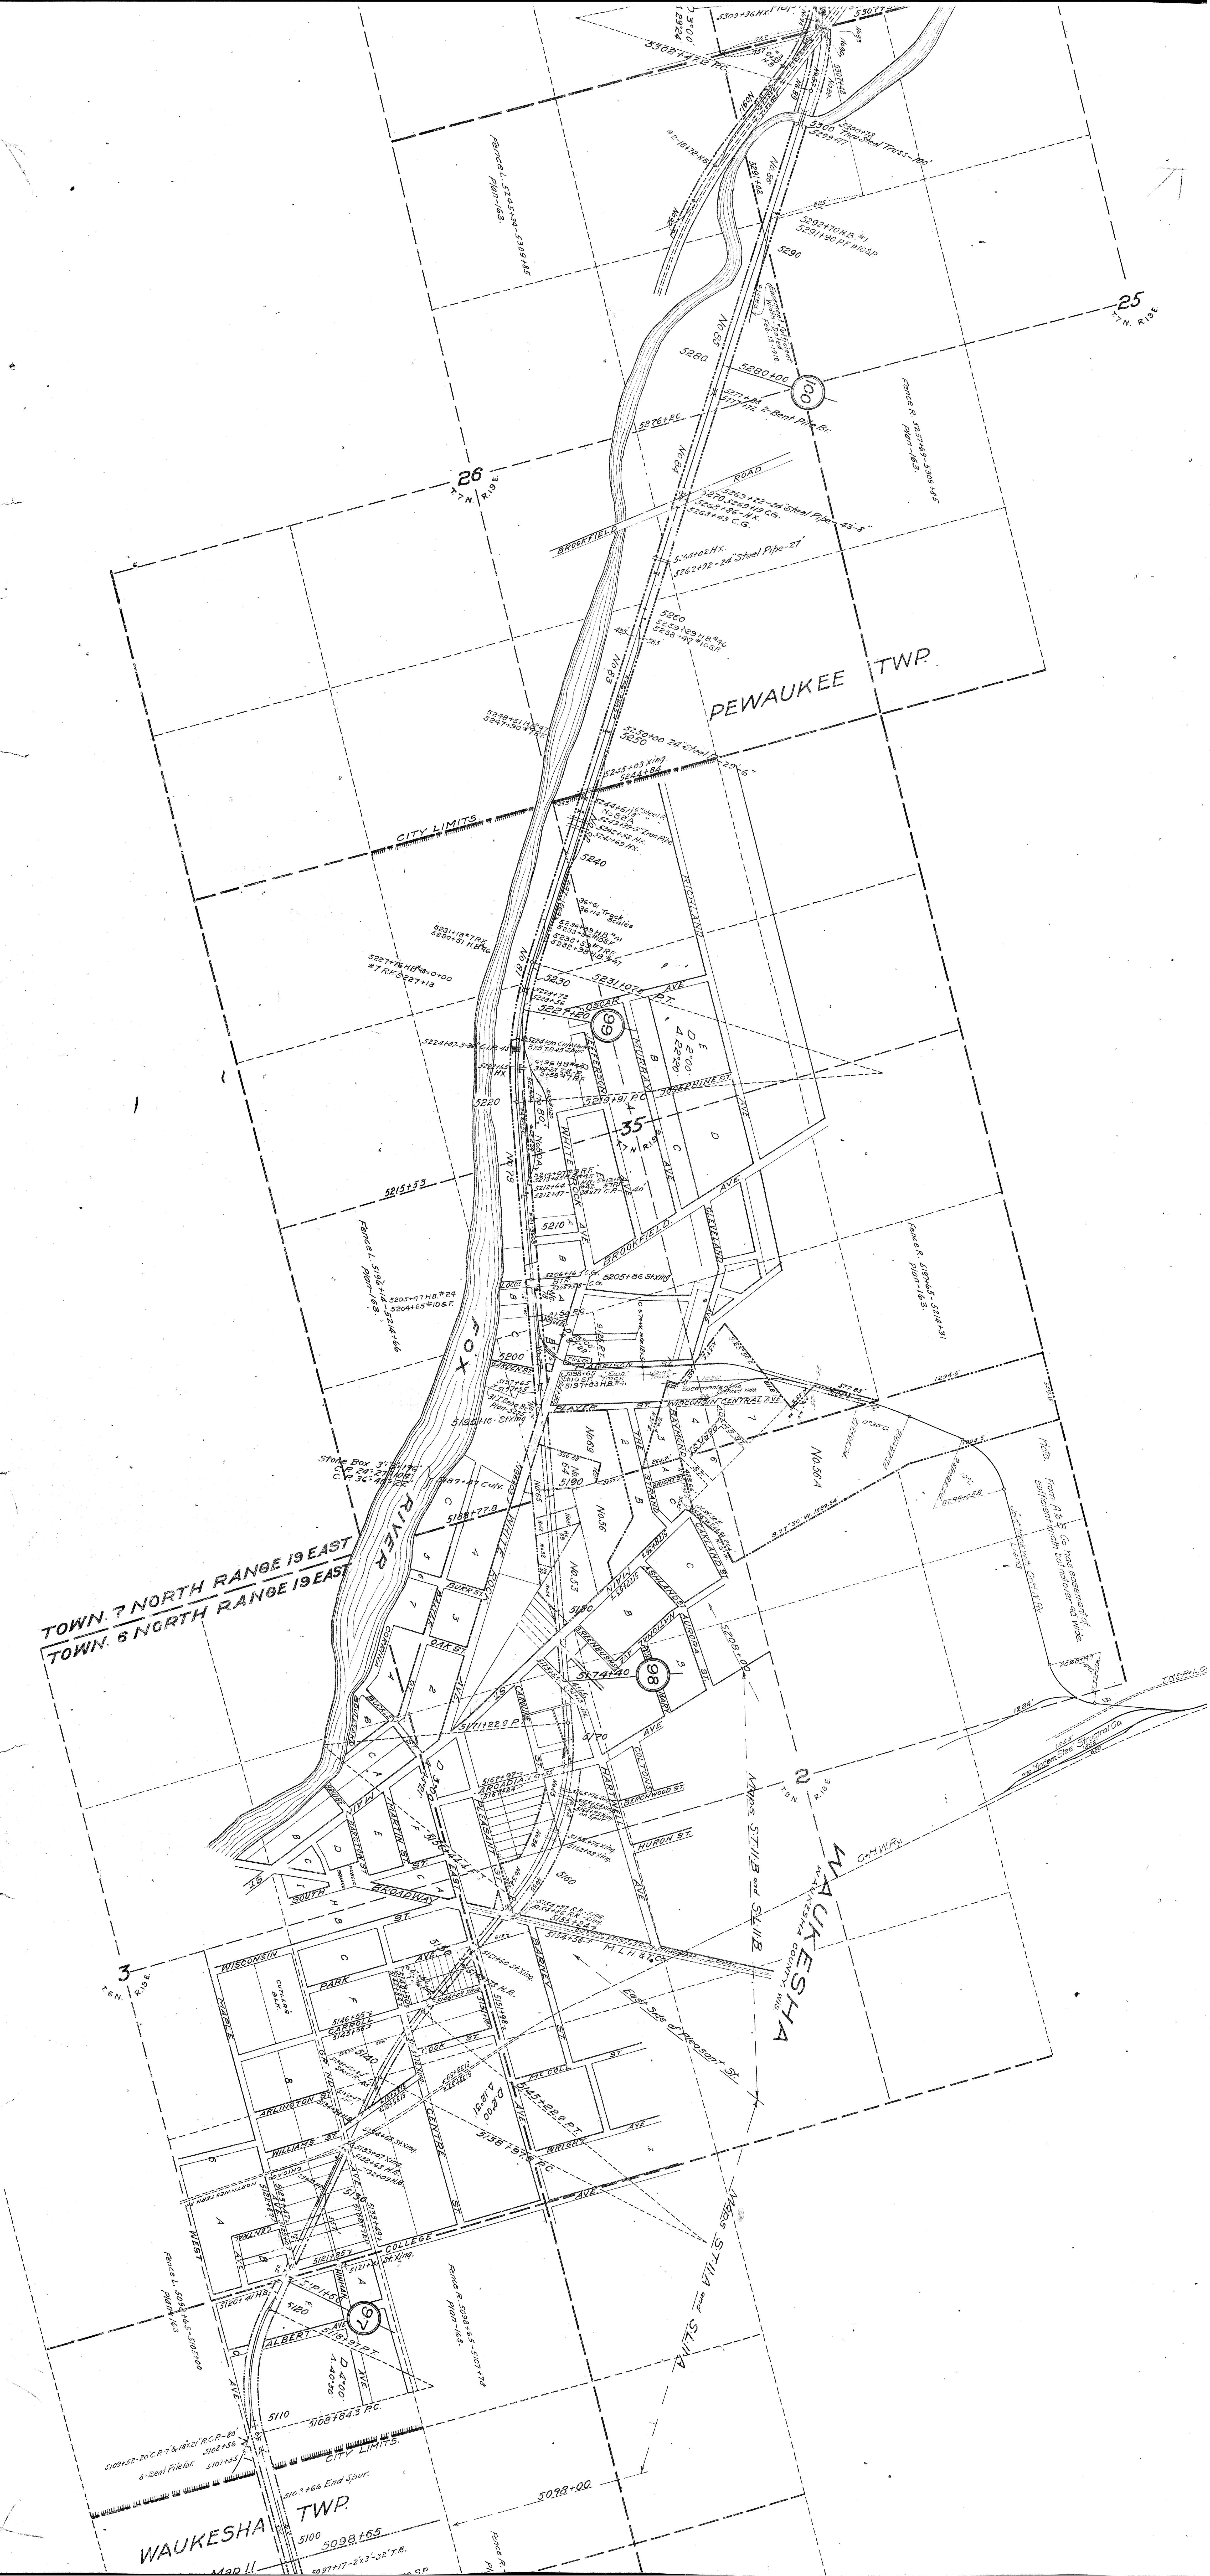

25
T. N. R. 19 E.

26
T. N. R. 19 E.

PEWAUKEE TWP.

CITY LIMITS

TOWN 7 NORTH RANGE 19 EAST
TOWN 6 NORTH RANGE 19 EAST

WAUKESHA

WAUKESHA TWP.