


FARMINGTON-TWP.
WAUPACA-TWP.

TOWNSHIP 22 NORTH RANGE 11 EAST
TOWNSHIP 22 NORTH RANGE 12 EAST

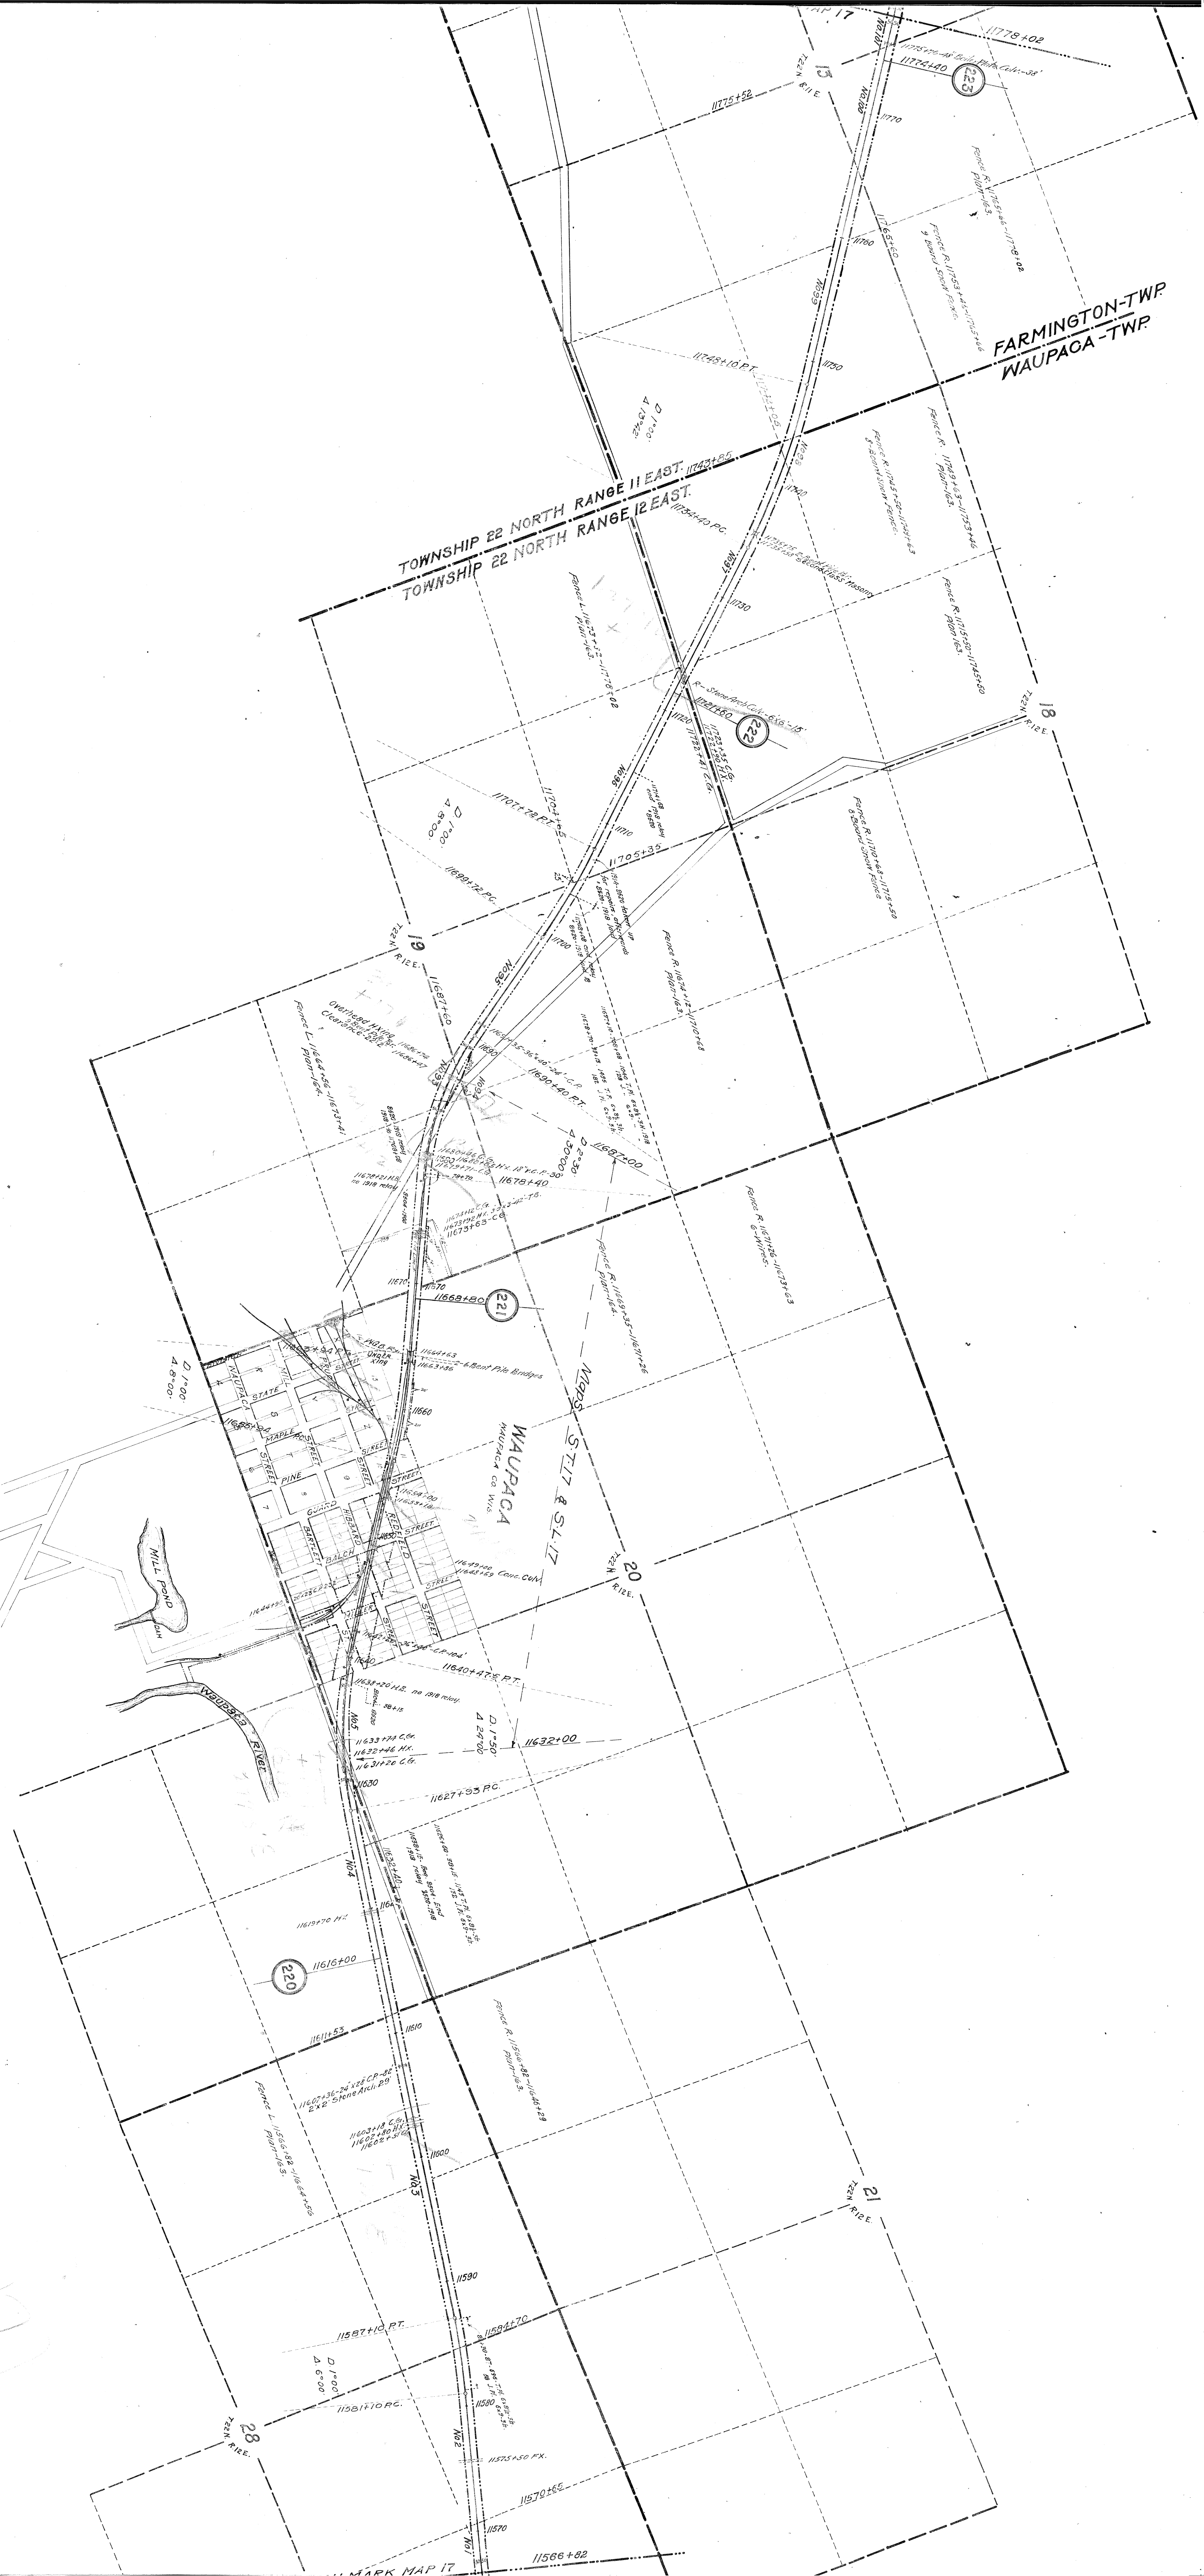

WAUPACA
WAUPACA CO. WIS.

Map S. 17 & S. 17

MILL POND

220

221

222

223

28

21

18

19

28

MARK MAP 17