


Fence L 18015+00-18038+274
Plan-163

THE TRACK No. 6

PRICE COUNTY, WIS.

Fence R 18015+00-18038+274
Plan-163

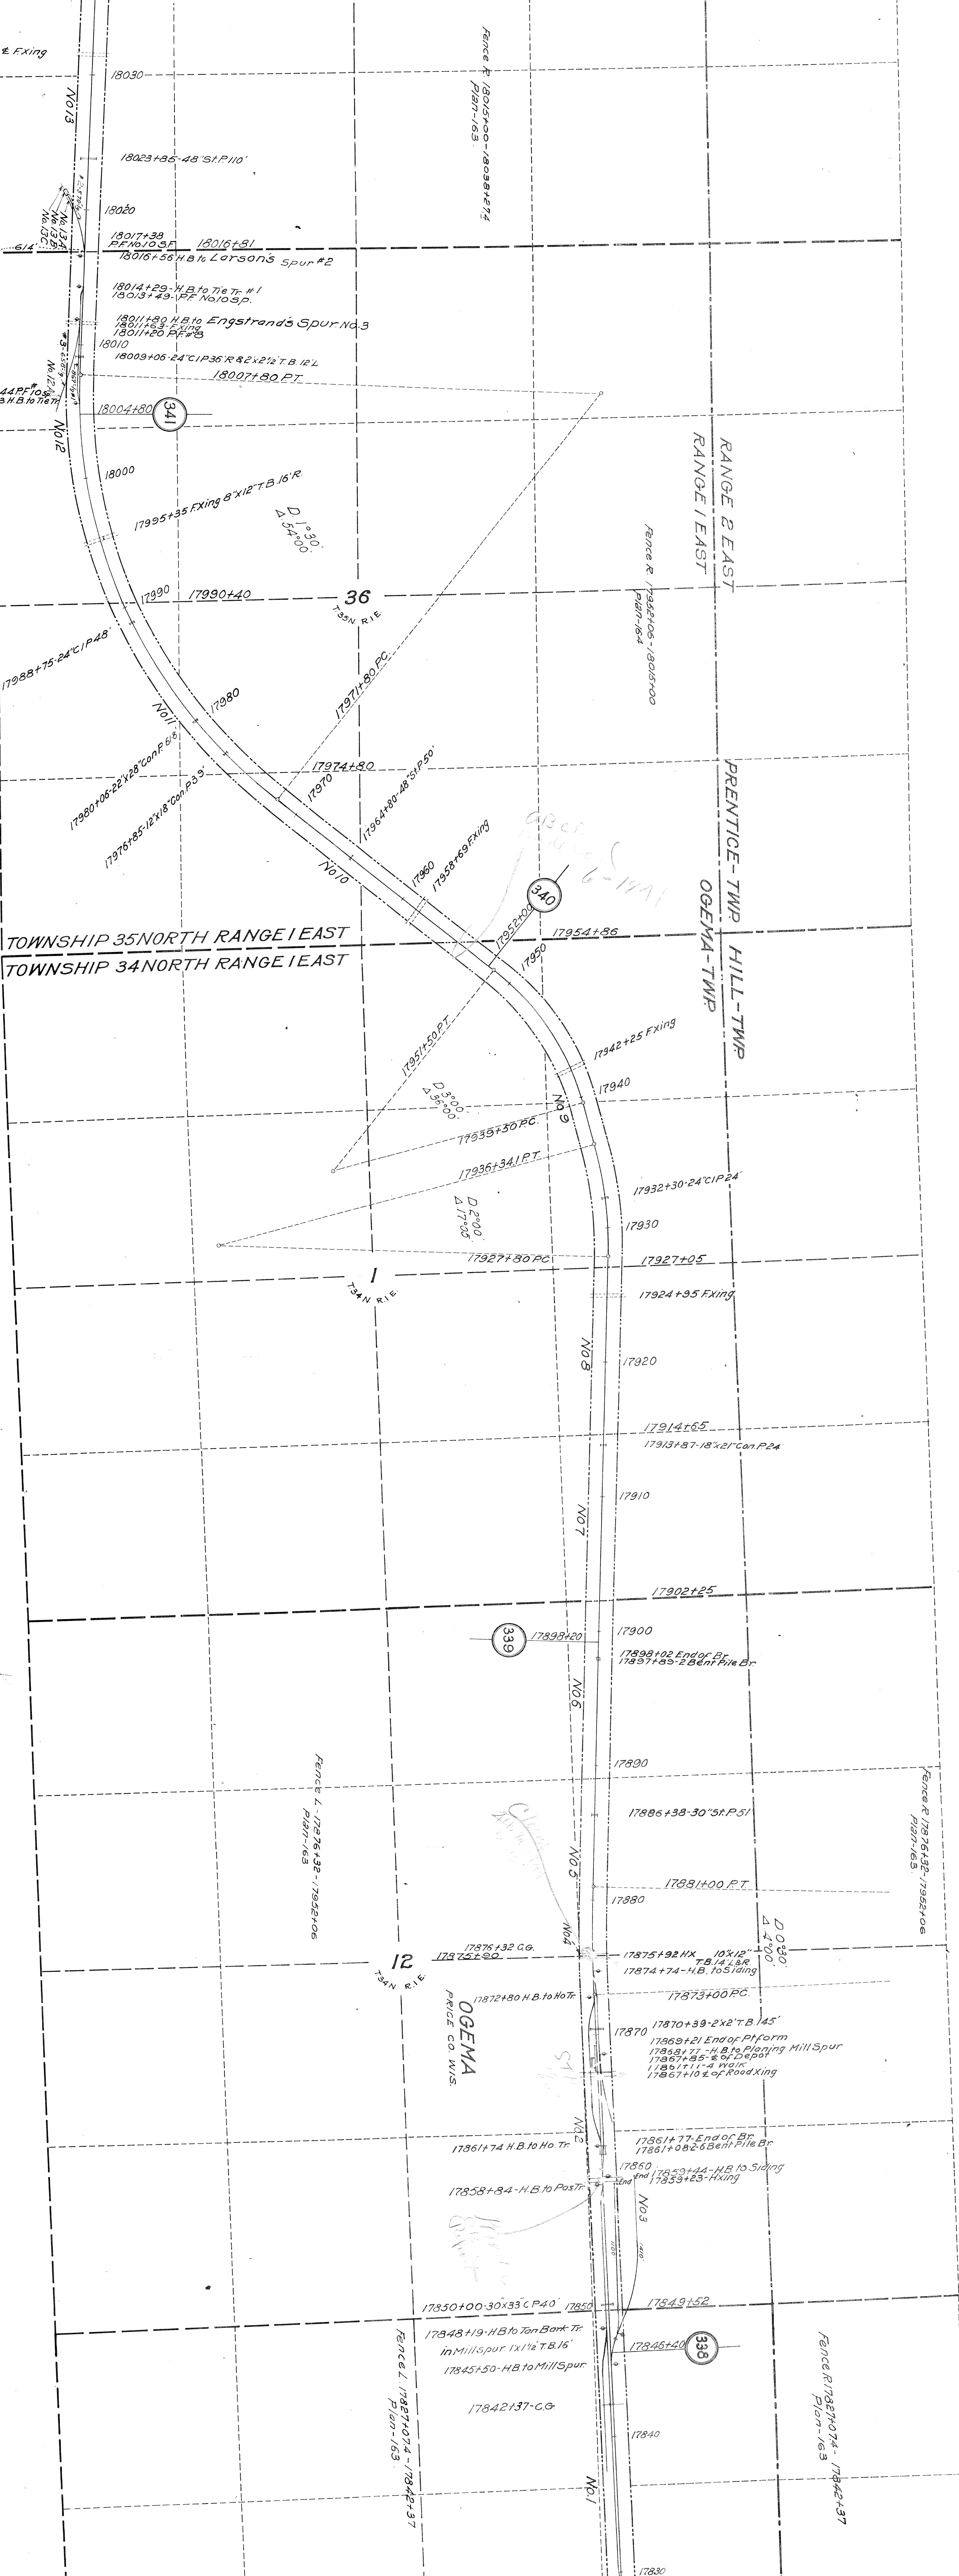

RANGE 2 EAST
RANGE 1 EAST

PRENTICE-TWP
OGEMA-TWP
HILL-TWP

TOWNSHIP 35 NORTH RANGE 1 EAST
TOWNSHIP 34 NORTH RANGE 1 EAST

12
T34N R1E

OGEMA
PRICE CO. WIS.

Fence R 17827+074-17842+37
Plan-163

Fence L 17827+074-17842+37
Plan-163