


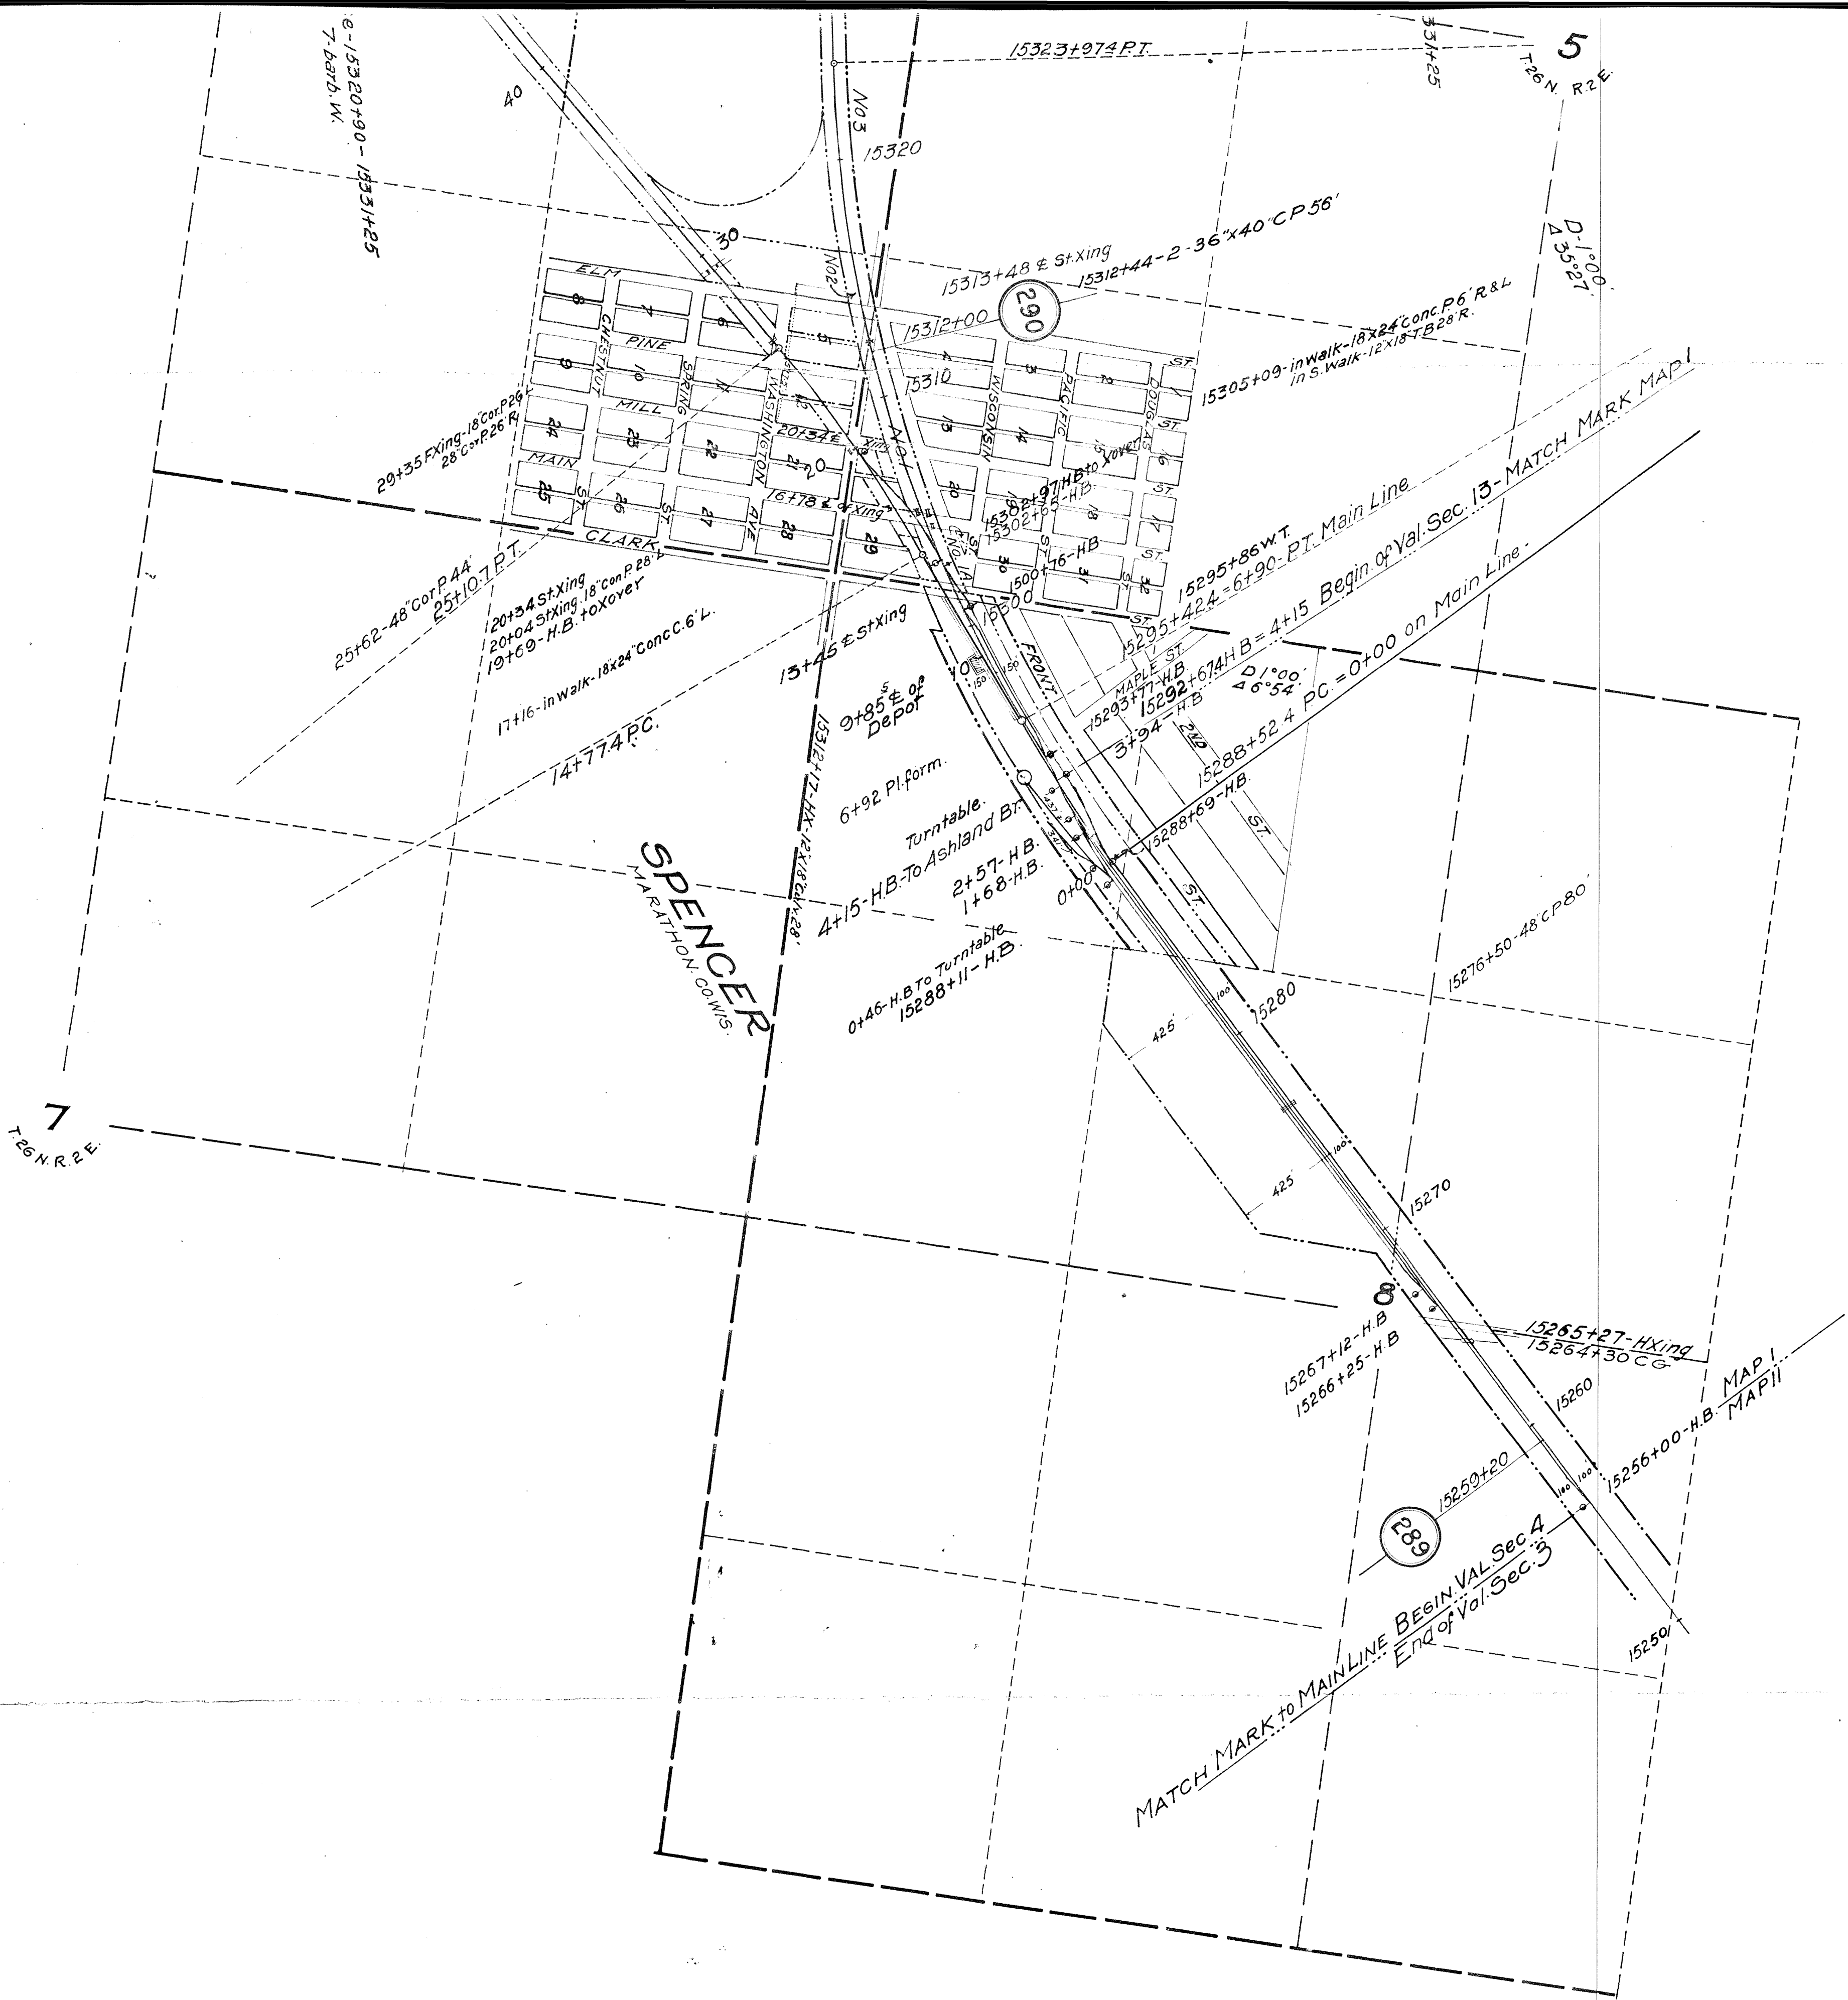

RIGHT-OF-WAY AND TRACK
 WISCONSIN CENTRAL RY CO
 MINNEAPOLIS ST PAUL & SAULT STE MARIE
 SPENCER TO ASHLAND
 CLARK AND MARATHON COUNTIES
 Station 15292+68 to Station 15320+74
 Mile Post 289+5548 to Mile Post 309+554
 Scale - 1 in = 400 ft. May 11 - 1917
 Office of Valuation Engineer
 Minneapolis Minn.
 Drawn by - LE SWAN Traced by AL JOHNSON
 Checked by - F. C. SEBURN

15516+84 C.G.
15516+47 Fxing
15516+13 C.G.

15516+47

15512+13-P-36" St. P. 33'

15510

15503+874

15500

15495+30 Fxing

15490
19
T27N R2E

15481+80 Fxing-12"x13" TB 16' L & R

15480

15470+40
15470
293

15467+30-42" St. P. 30' 3"
15466+89 H.B.

15463+13 Fxing-1x1 1/2 TB-24' L
15462+78 End of Bridge
15462+21 Cinder Pl. form.

15460

15456+40 Road Xing
15456+10 C.G.

15450

15448+29 H.B.
15447+78 End of Bridge
15447+20-3 Bent Ave Tr. Br.

15440

15436+38

15430

15420

15417+60
292

15410

15409+80 C.G.
15409+09 C.G.

15400

15393+51 Fxing-5"x12" TB 14' L & R

15390

15386+40 Fxing 24" Tile P17-R

15380

15375+47-Conc. P

15370

15369+45

15360

15356+70 C.G.
15356+11 C.G.

15350

15346+35 CIP

15340

15342+73 FX
15342+73 L&R

15330

15329+47 FX-4"x10" TB 64' L & R

MATCH MARK MAP 2
MAP 1

Fence-15478+00-15495+00
Snow Fence

Fence-15496+00-15503+874
Plan-163

Fence-15463+43-15478+00
Plan-163

15463+13
15463+43 C.G.
ROMEO
MARATHON CO. WIS.

Fence-15423+10-15456+10
Plan-163

Fence-15416+08-15423+10
19-88 ft. W.
Hog Wire Fence

Fence-15393+60-15413+30
Snow Fence

Fence-15368+00-15393+60
Plan-163

Fence-15356+70-15368+00
Snow Fence

Fence-15341+56-15356+11
326' C.
S.B.C.

Fence-15331+25-15341+56
Snow Fence

Fence-15413+30-15456+10
Plan-163

Fence-15400+47-15413+30
Snow Fence

Fence-15368+00-15400+47
Plan-163

Fence-15336+10-15368+00
Snow Fence


BRIGHTON TWP
TOWNSHIP 27 NORTH RANGE 2 EAST
TOWNSHIP 26 NORTH RANGE 2 EAST
SPENCER TWP

Fence-15331+25-15341+56
Snow Fence


Fence-15312+64-
Plan-16


MARATHON CO. WIS.
RANGE 2 EAST
RANGE 1 EAST
CLARK CO. WIS.


6
T26N R2E

 


ATHON CO. WIS.
R.K. CO. WIS.

 

 

 

 

CHELSEA-TWP
MEDFORD-TWP
TOWNSHIP 32 NORTH RANGE 1 EAST
TOWNSHIP 31 NORTH RANGE 1 EAST

MATCH MARK MAP 8
17747.2

Fence R 16894+11 - 16894+27
Fence R 16894+11 - 16894+27
 

 

 

THE TRACK No. 6
PRICE COUNTY, WIS.

TOWNSHIP 35 NORTH RANGE 1 EAST
TOWNSHIP 34 NORTH RANGE 1 EAST

RANGE 2 EAST
RANGE 1 EAST
PRENTICE TWP
HILL TWP
OGEMA TWP


OGEMA
PRICE CO. WIS.

Fence R 1787074-17842+37
Plan-163


Fence L 17827074-17842+37
Plan-163


Fence L 17876+32-17852+06
Plan-163


Fence R 17876+32-17852+06
Plan-163

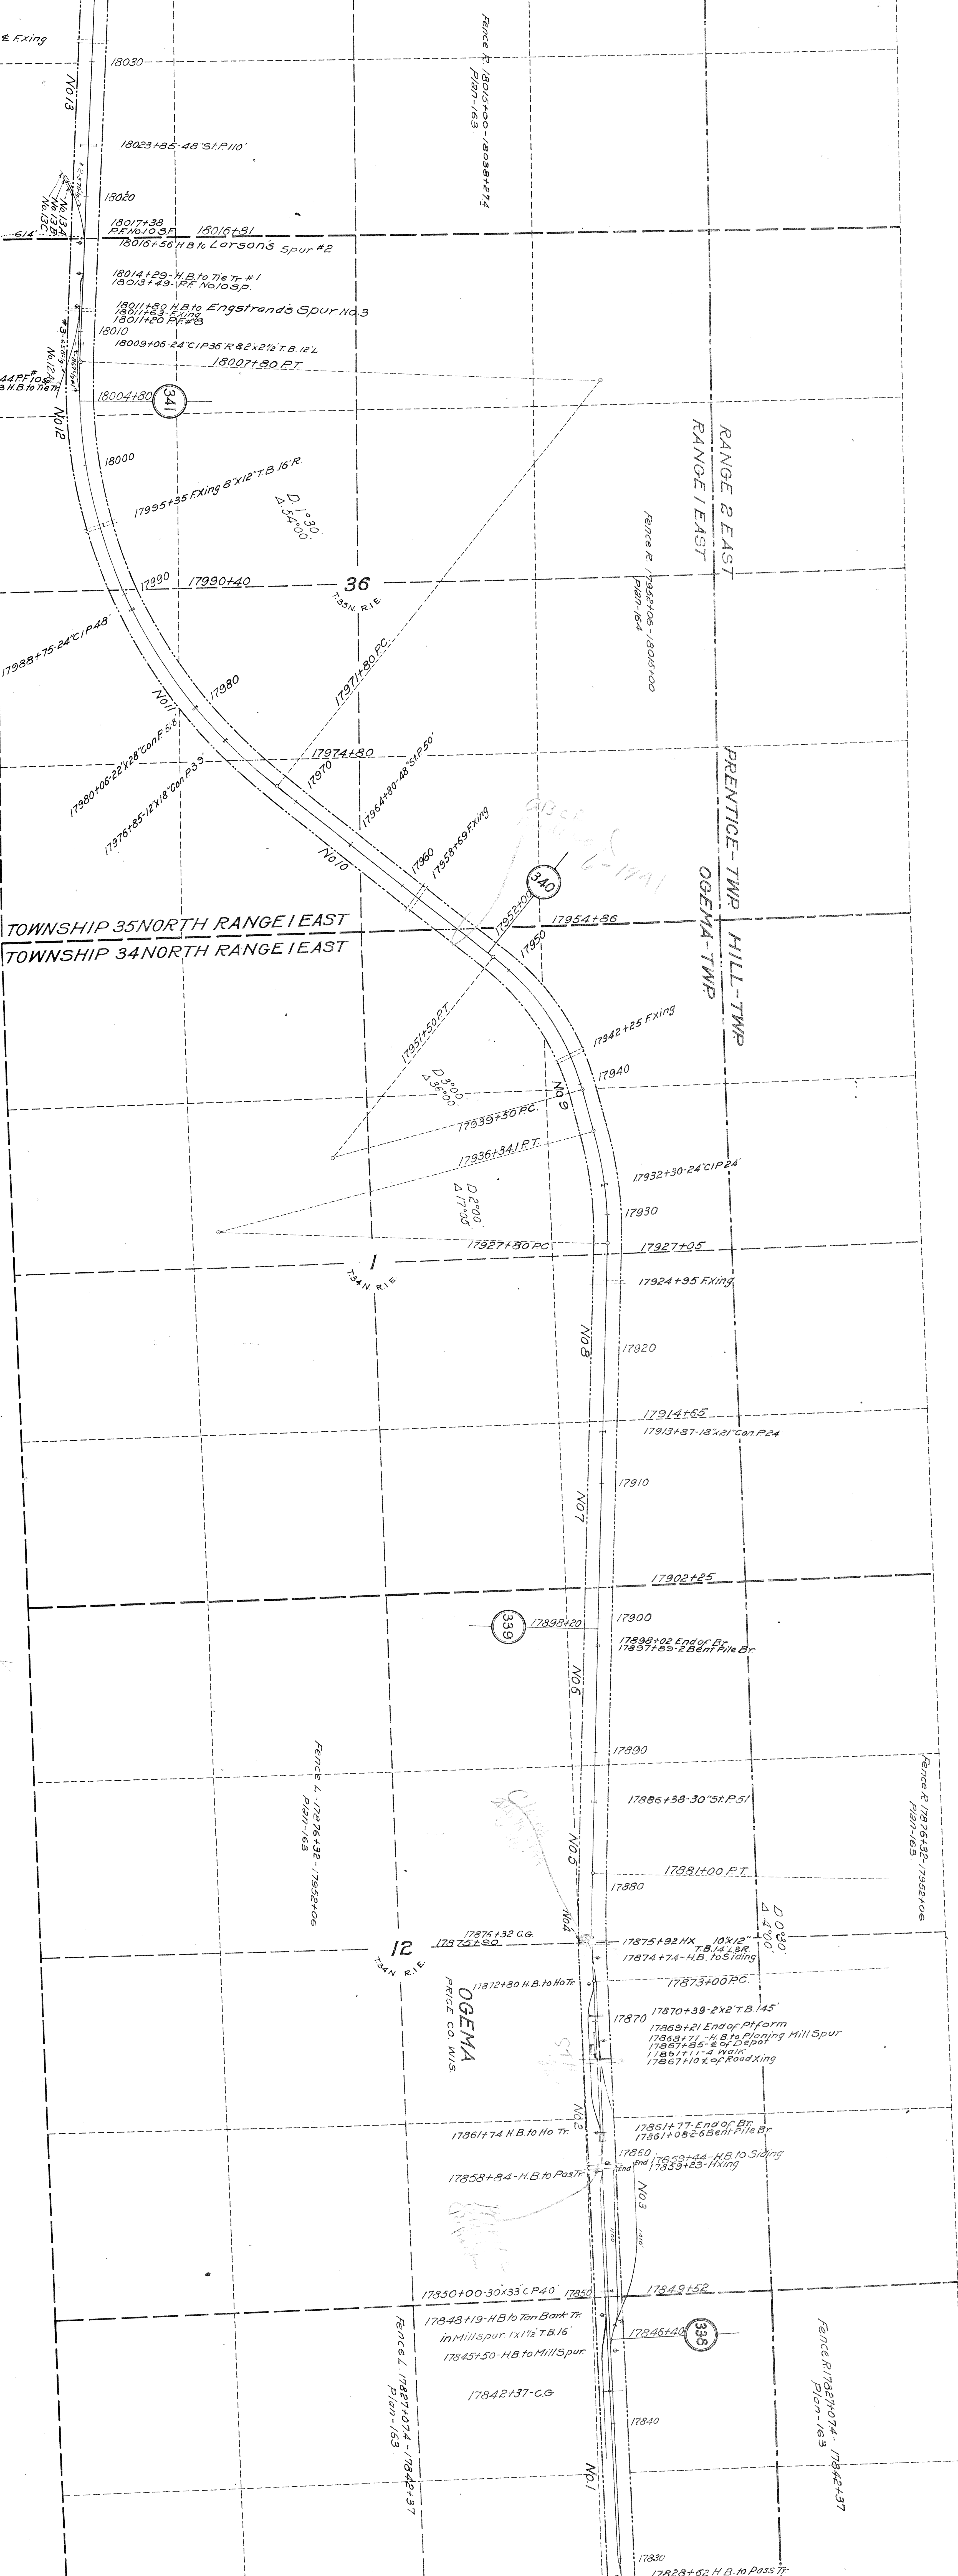


Fence R 18237+38 - 18249+174
Plan 103
5/1/63

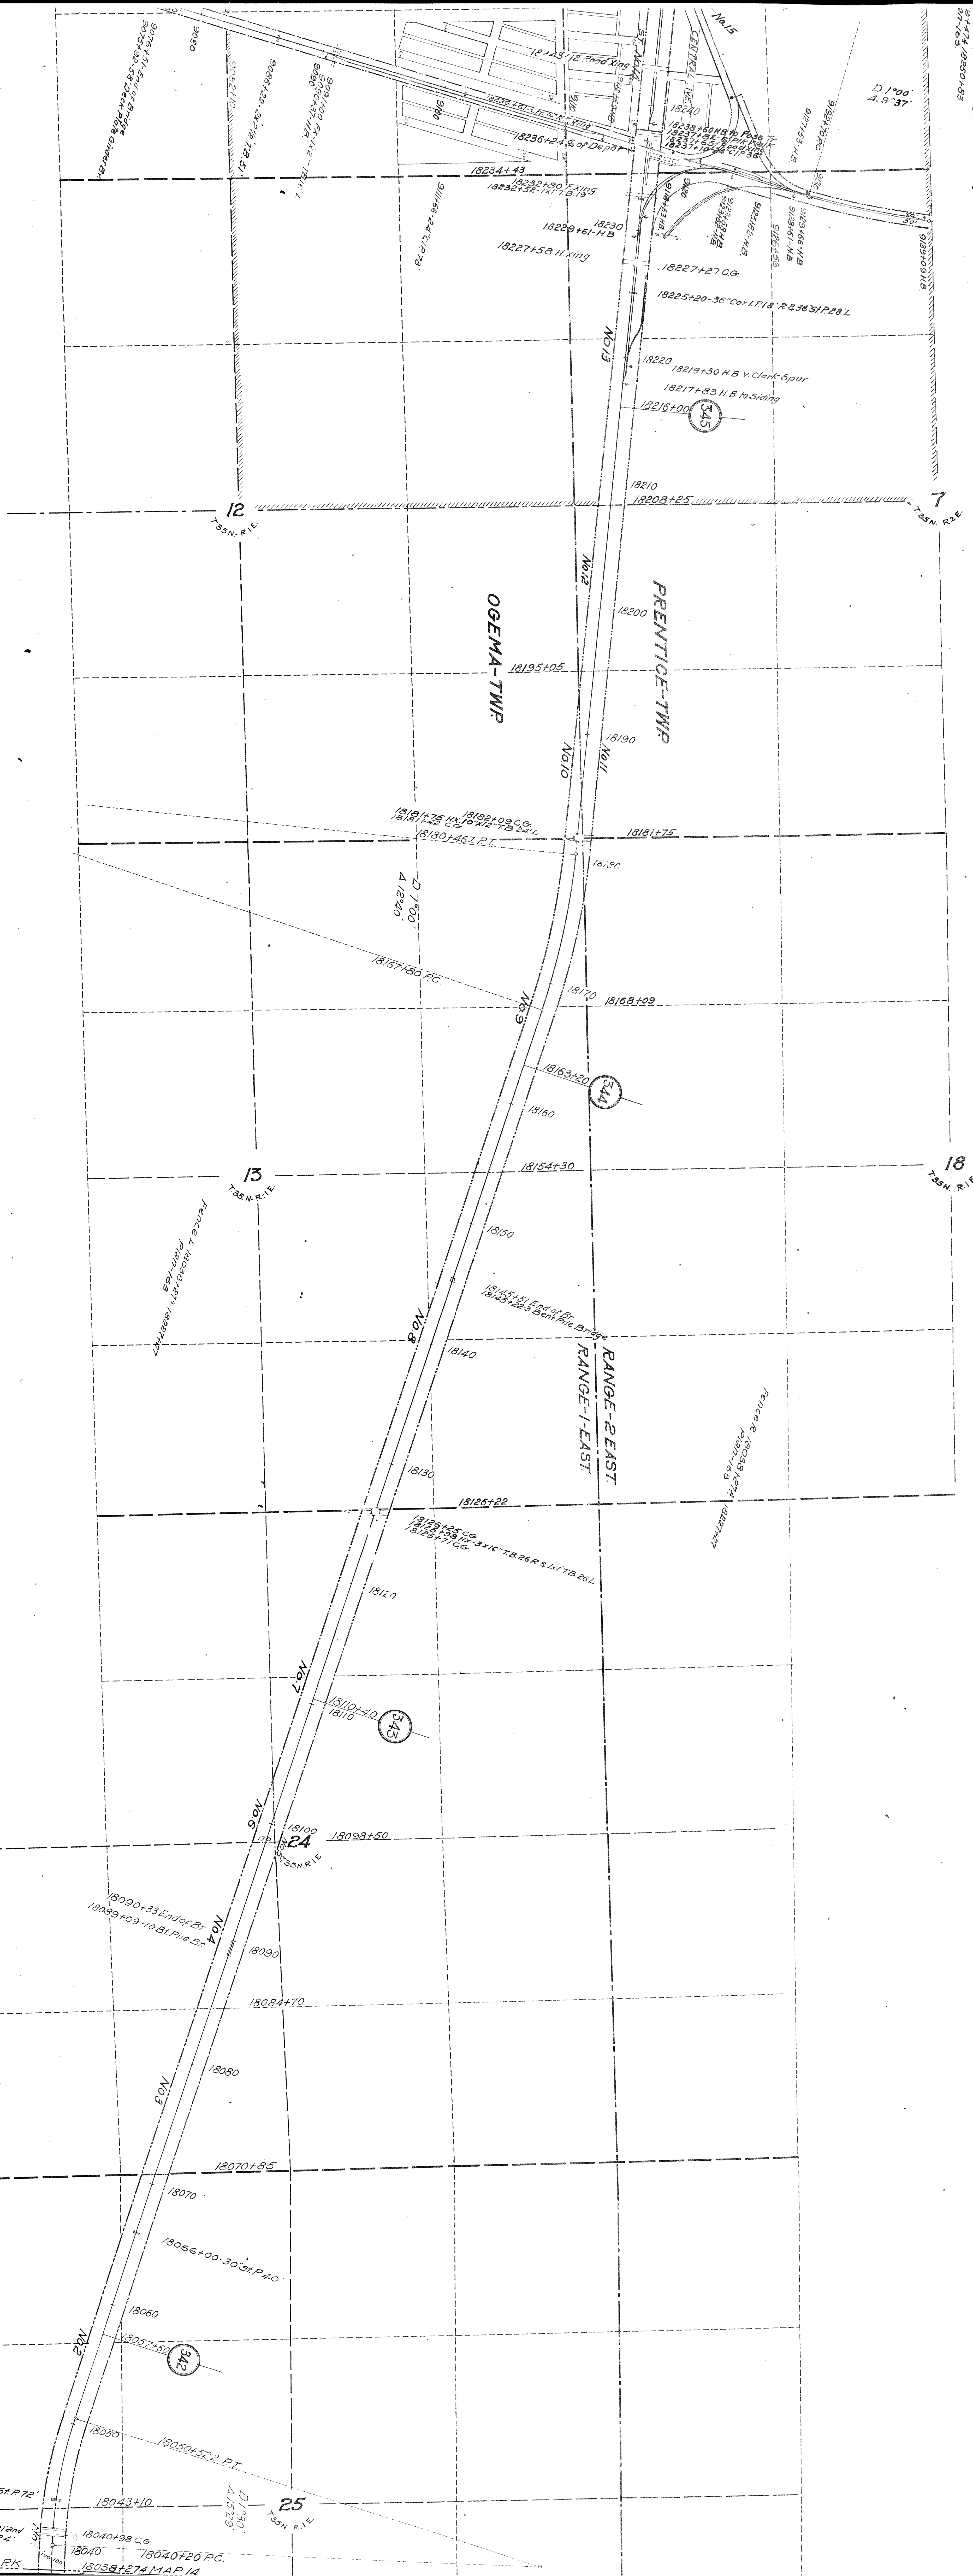


 


 


 




 

 

 

MATCH MAP 1 MAP 22

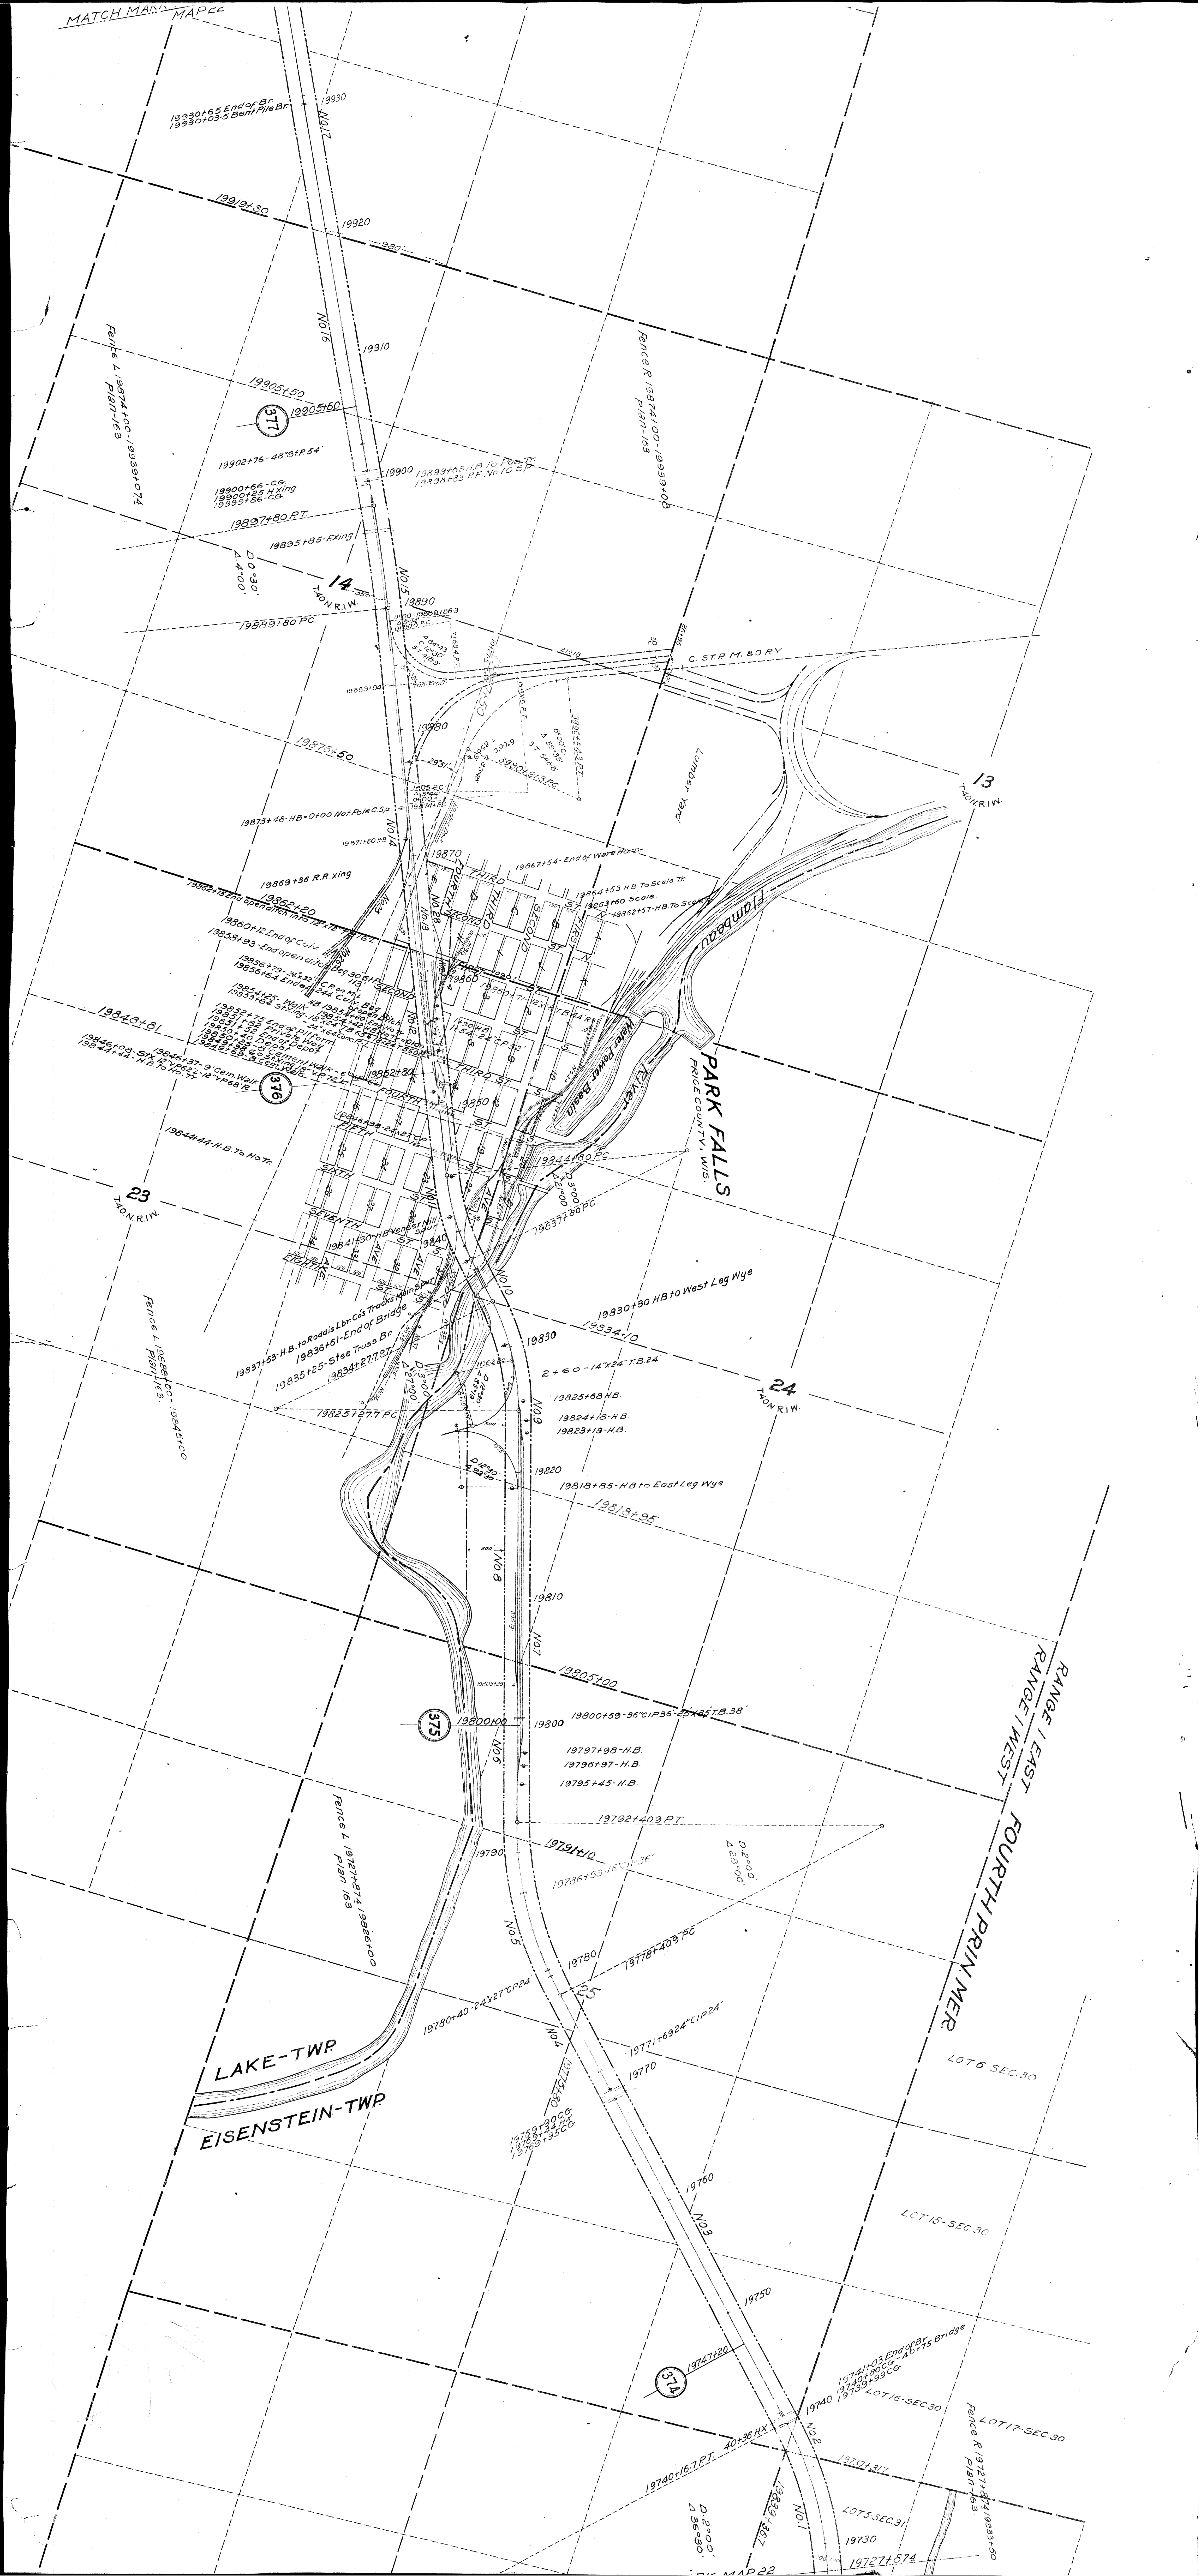

19930+65 End of Br.
19930+03-5 Bent Pile Br

19919+50

19930

19920

19910

19905+50

19905+50

19902+76-48-51 P. 54

19900+55-50
19900+25-50 Xing
19900+56-50

19897+80-PT

19895+85-50 Xing

19893+80-PC

19893+80-PC

Fence R. 19874+00-19939+08
P. 1/31-1/33

Lumber Yard

PARK FALLS
PRICE COUNTY, WIS.

19830+30 HB to West Leg Wye

19825+68 HB
19824+18 HB
19823+19 HB

19818+85 HB to East Leg Wye

19819+95

19810

19807

19805+00

19800

19800+59-35-51 P. 36-25-25 B. 38

19797+98 HB

19796+97 HB

19795+45 HB

19792+409 PT

19791+10

19786+93-18-18 P. 36

19780

19778+409 PC

19770

19771+6924-51 P. 24

19770

19760

19750

19747+20

19740

19739+317

19730

19727+574

19720

19710

ASHLAND COUNTY WISCONSIN

AGENDA-TWP

LAKE-TWP

PRICE COUNTY WISCONSIN

MATCH MARK MAP VAL. SEC. 14 WIS.
MAP 33 VAL. SEC. 13 WIS.

20045+21-HB
20043+07-HB

TOWN 41 NORTH
TOWN 40 NORTH

20025+69-PC

Bridge 20017+31
20017+00

20010+20

3

20003+25-48'42" CP 64
20003+63-21'2" TP 48'
20002+12-24'48" CP 24

Bridge 19970+55
19970+24

Fence L 19939+07-20032+49
Plan 163

19955+20-CG
19954+33-HX
19954+09-CG

19950

19940

19939+07.4

Fence R 19939+00-19933+00
Plan 163

Fence R 19933+00-19935+00
7 1/2 Miles
Plan 163

Fence R 20042+00-20032+49
Plan 163

2

1/4" N. R. W.